

Name Priscilla D. Pendergast

Service No. 133

Address 12 Appletree Lane

Location

Kind of Pipe AC

Size 6"

Size of Main

~~Repair, Renewal~~ - New Service Valeri Const. #2776


Location Comm. Aug. 16, 1976

Date	Material	Amount	Total	Date	Amount
7/7/75	26' 6" AC @ \$10.00		\$260.00	11-6-75	260.00
11/25/75	52' 6" Transite Pipe				
	10' 4" Cast Iron Pipe				
	10' 3" Cast Iron Pipe				
	REPAIR - Redmond #3835				
8/5/83	1 6 x 6 Wye				
	1 Fernco Adpt.				
	1 AC to PVC Adpt.				
	25'6" 6" PVC				
	10' 4" PVC				
	4" x 6" Donut				

DATE \_\_\_\_\_

TOWN OF LEXINGTON — BOARD OF PUBLIC WORKS  
SEWER DIVISION

Sketch of Service Here

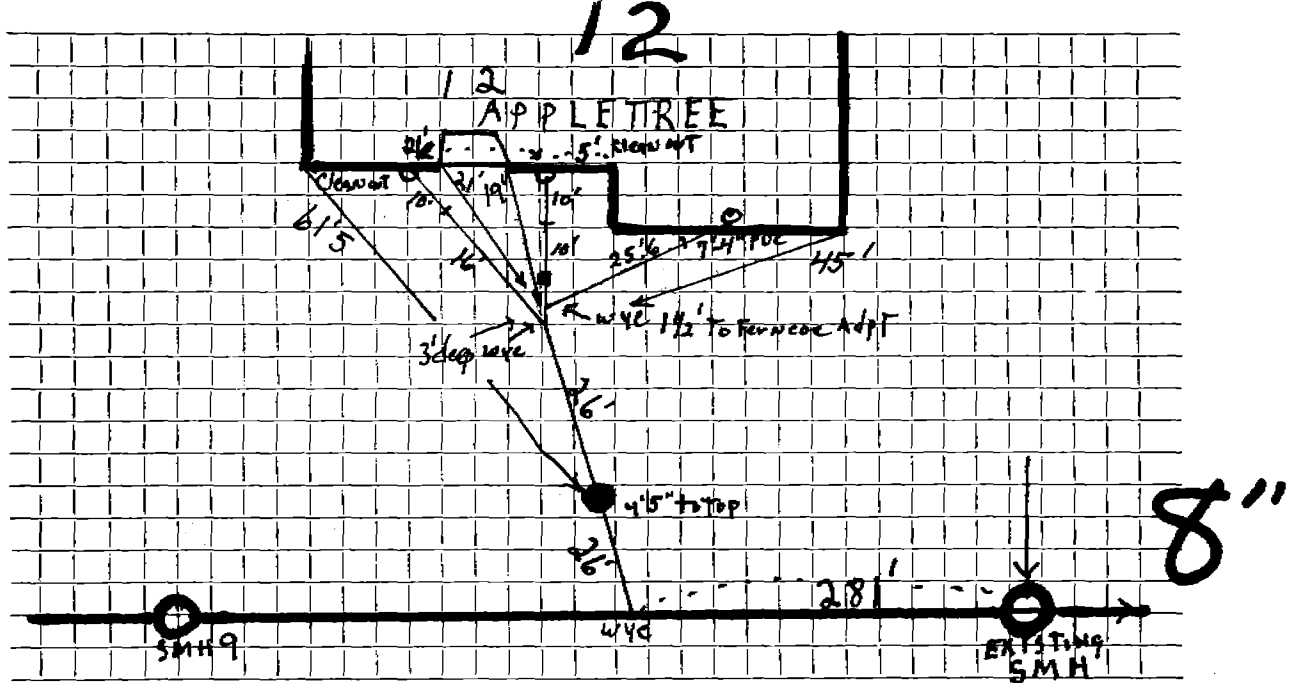

Connection made in ..... Street. Work completed .....

Remarks: .....

.....

.....