

Name

Service No.

Address 120 APPLE TREE LN

Location

Kind of Pipe

SDR 35

Size

6" PVC

Size of Main

Repair—Renewal—New Service

Location

Date

Material

Amount

Total

Date

Amount

4/15/15

- 6" SDR

- 6" CLEAN OUT

- 6" SDR PISUN

- 6" PVC CAP

- 6" TEE W/1"

- 22" DEND, PVC 2


11" DEND, PVC 1

- 6" x 6" FERRIS

DATE 4/15/15

TOWN OF LEXINGTON — BOARD OF PUBLIC WORKS  
SEWER DIVISION

Sketch of Service Here

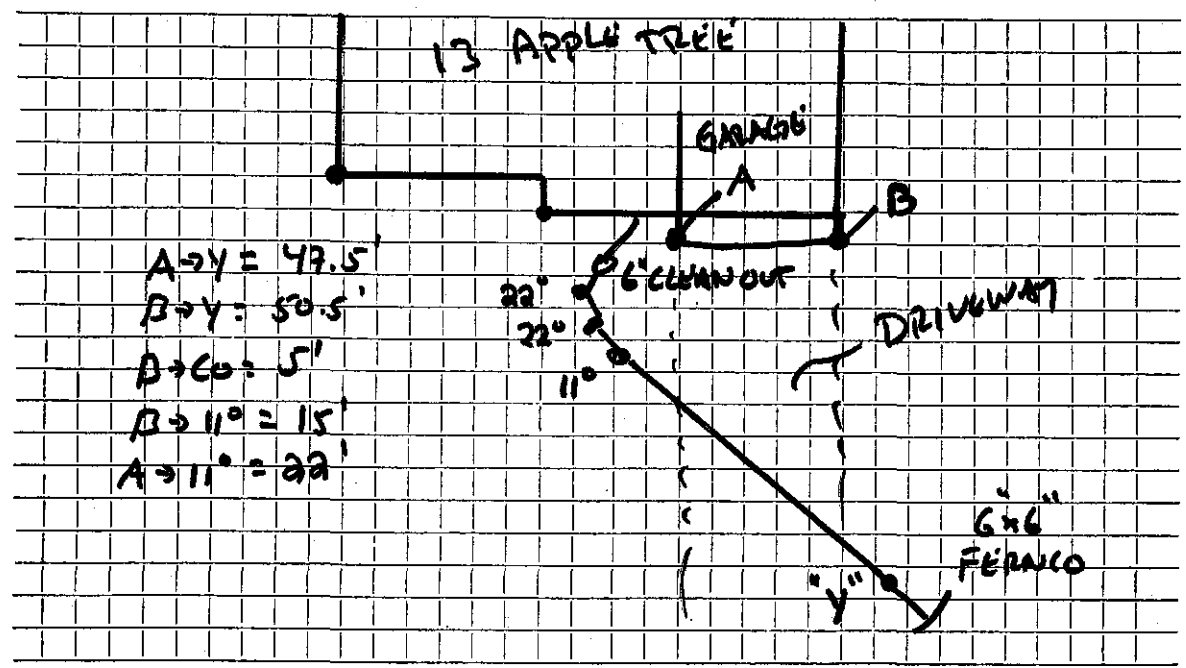

A → Y = 47.5'  
B → Y = 50.5'  
B → CO = 5'  
B → 11° = 15'  
A → 11° = 22'

Connection made in APPLE TREE Street. Work completed DAVE SANTO

Remarks: .....

.....

.....