


DATE _____

TOWN OF LEXINGTON — BOARD OF PUBLIC WORKS
SEWER DIVISION

Sketch of Service Here

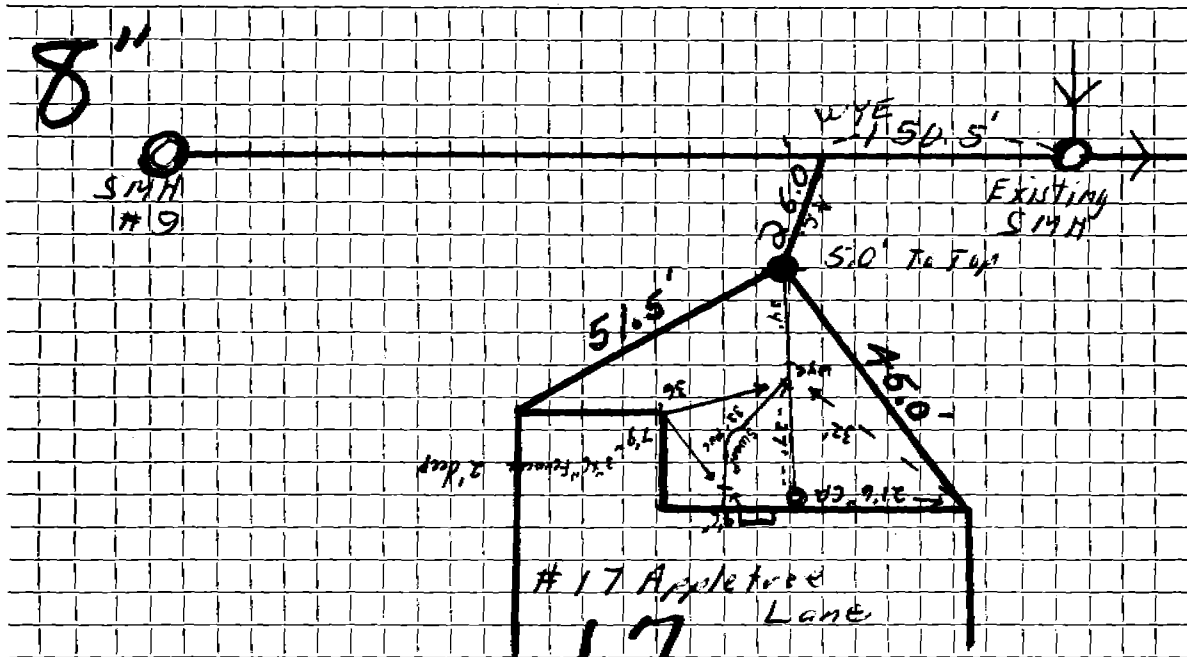

Connection made in *Apple tree*..... Street. Work completed

Remarks:

.....

.....