




DATE MAY 22 1998

TOWN OF LEXINGTON — BOARD OF PUBLIC WORKS  
SEWER DIVISION

Sketch of Service Here

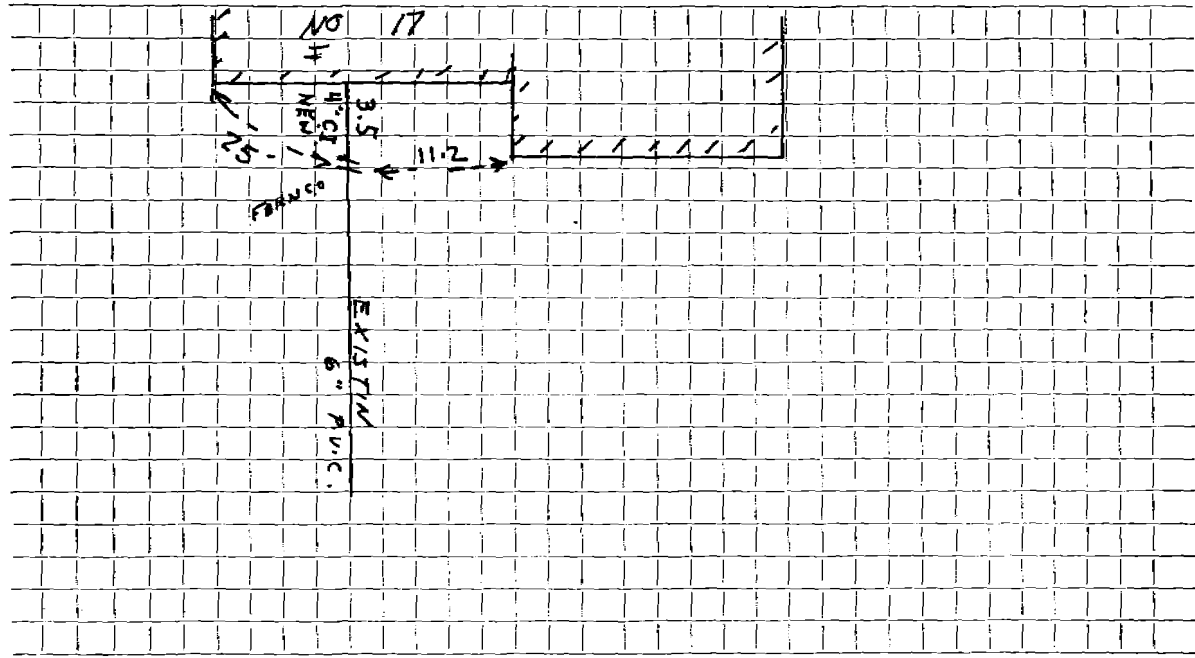

Connection made in APPLETREE LANE Street.

Work completed CIMINA CONTRACTING

Remarks: .....  
FIELD BOOK 98-1 ..... TJM .....