

Name Patricia Connors

Service No. 23

Address 19 Appletree Lane

Location

Kind of Pipe AC

Size 6"

Size of Main 8"

~~Revised~~ New Service Valeri #3497

Location AUG 4 1980


Date	Material	Amount	Total	Date	Amount
7-3	75 31'-6" AC at	10.00 =	210.00	6-17-80	Deposit 210.00
6-19-80	61' 6" Transite pipe				
	25' C. I. pipe				

DATE _____

TOWN OF LEXINGTON — BOARD OF PUBLIC WORKS

SEWER DIVISION

Sketch of Service Here

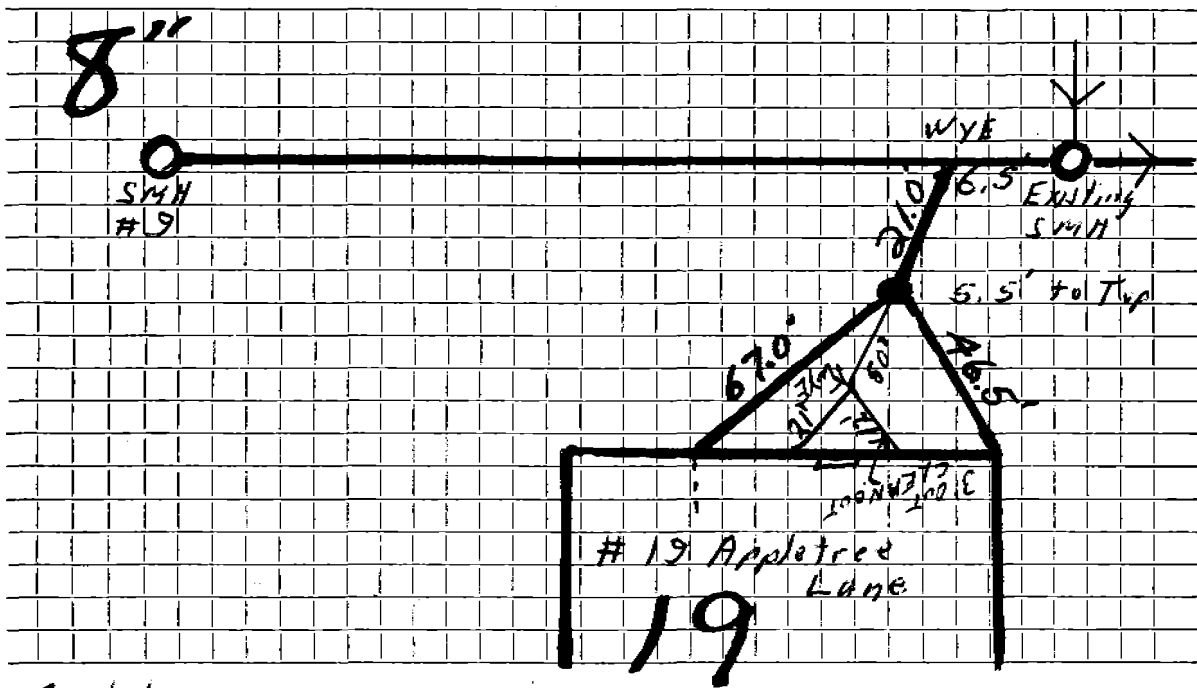

Connection made in *Appletree* Street. Work completed

Remarks:
.....
.....