

Name George J. Primes

Service No. 34

1977

Address 3 Appletree Lane

Location

JUN 20 1977

Kind of Pipe AC

Size 6"

Size of Main 8"

~~Repair~~ ~~Renewal~~ New Service Valeri Const. #3291


Location

Date	Material	Amount	Total	Date	Amount
7-7 75	26'-6" AC at	*10.00 =	*260.00	5/27/77	260.00
5/31/77	424'	6" transite			
	10'	4" cast iron			

DATE \_\_\_\_\_

TOWN OF LEXINGTON — BOARD OF PUBLIC WORKS  
SEWER DIVISION

Sketch of Service Here

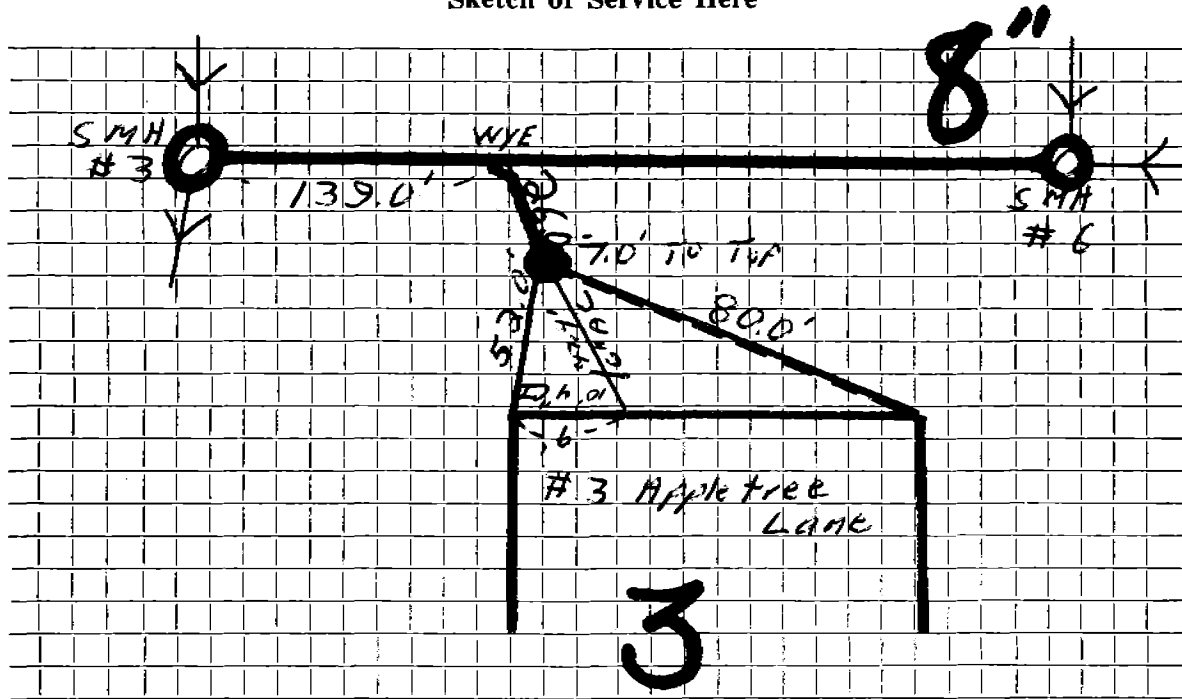

Connection made in Apple tree Street. Work completed .....

Remarks: .....  
.....  
.....