


DATE _____

TOWN OF LEXINGTON — BOARD OF PUBLIC WORKS

SEWER DIVISION

Sketch of Service Here

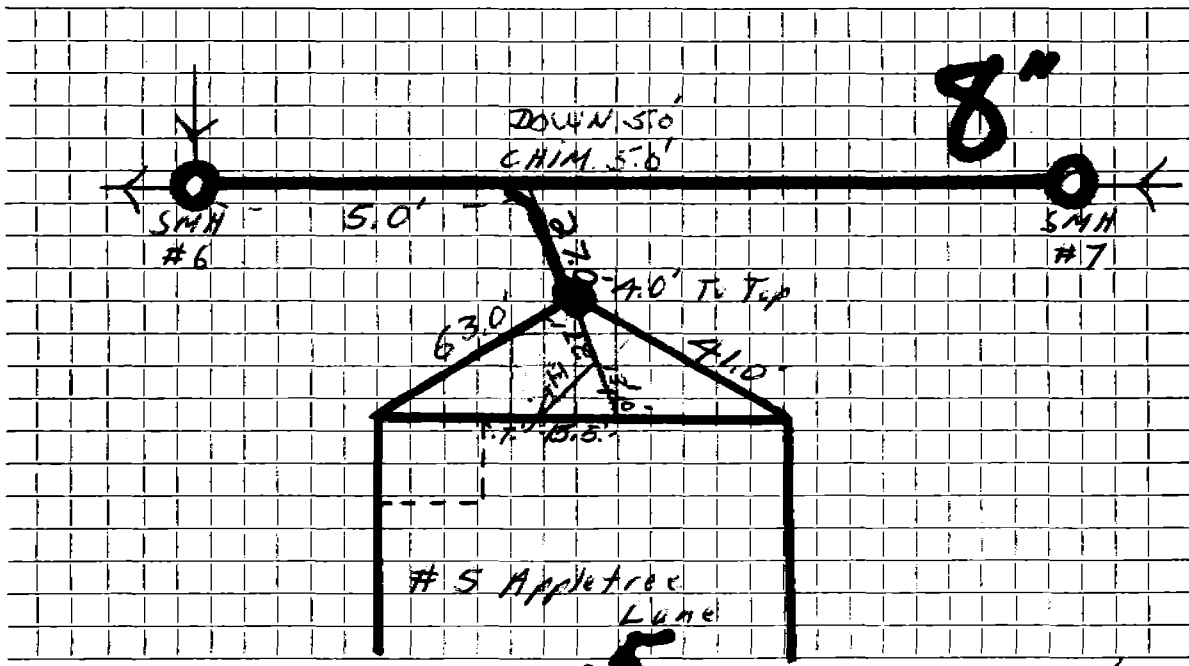

Connection made in **#5** *Apple tree Lane* Street. **5** Work completed ... *11/25/75*

Remarks:

.....

.....