

Name

Service No.

Address 30 Arcola Street

Location

Kind of Pipe

Size

Size of Main

~~REPAIR~~—Renewal—~~REPAIR SERVICE~~ W.O. #1378

Location

Date

Material

Amount

Total

Date

Amount

11-21-55

40' 6" Sewer Pipe

OUTSIDE

9/6/80

Labor

1 6" x 10' Transite pipe

1 6" x 5' Transite Nipple

1 6" x 2' Transite Nipple

2 6" Fenco Coup.

1 yd. Loam

5 lbs. Grass Seed

Lime & Turf Food

Patch 7' x 10'

12-22-67 Roots

6½ Trucking

9-12-80 Roots 35'-40' out

3 hrs. Town Shovel

3-6-55 Roots 7' 4 1/2'


1 hr. Compressor

1 hr. Roller

DATE _____

TOWN OF LEXINGTON — BOARD OF PUBLIC WORKS
SEWER DIVISION

Sketch of Service Here

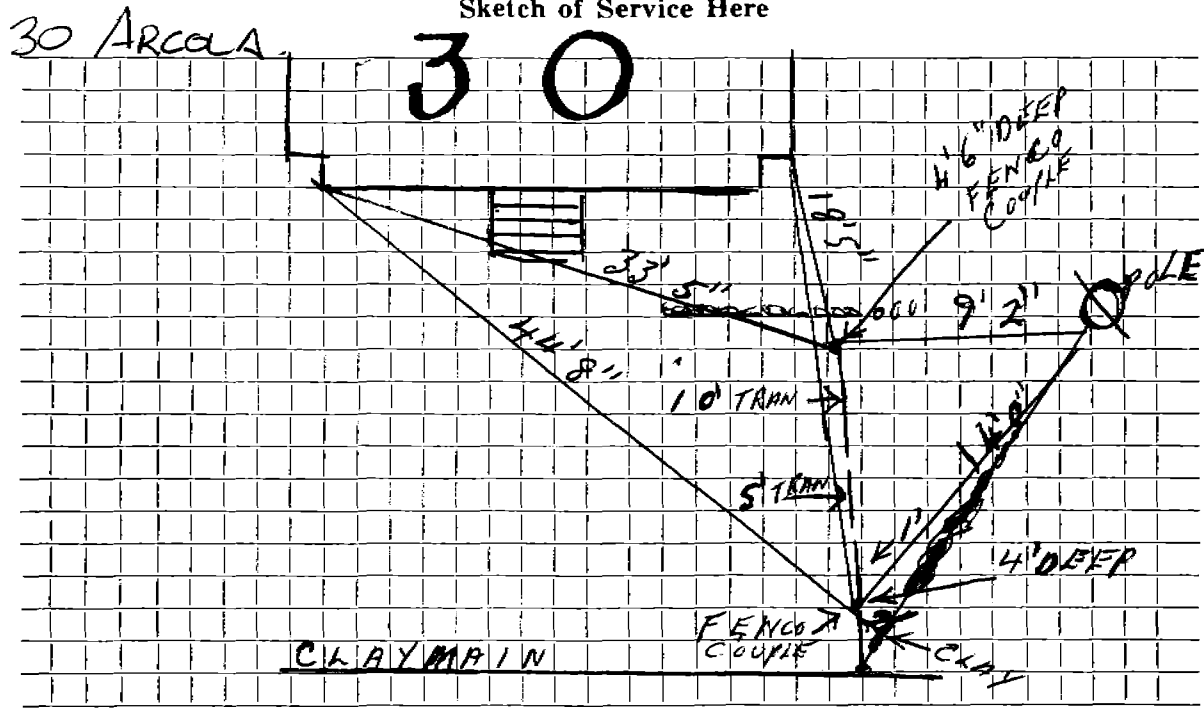

Connection made in Street. Work completed

Remarks:
.....
.....