

Name William Abbott

Service No. 185

Address 32 Arcola Street

Location

Kind of Pipe

Size

Size of Main

Report Renewal - New Service

Com. 12-31-55

Location

Date	Material	Amount	Total	Date	Amount
10/28/55	Labor	40 77		9-9-55	100 00
	10% overhead	4 08	44 85	12-31-55	70
	30' - 6" sewer pipe @ .32		9 60		NON CHARGE
	1 - 6" elbow		1 88	10/28/55	3 00
	joint compound		1 80	4 hrs. Littlefield shovel	8 50
	4-2/3 hrs. Littlefield shovel				37 00
	@ 8.50		39 67		Renewal - Outside
	2 hrs. trucking @ .75		1 50	7/6/83	20' 6" P.V.C.
			99 30	2	6" Fernco Adapter
					P.V.C. to Clay
				2	Ton Cold Patch
	Labor				Patch 12' x 16'
				6-22-83	Roots 32' Out

TOWN OF LEXINGTON—DEPT. OF PUBLIC WORKS

SEWER DIVISION

DATE .....


NO. ....

The undersigned applies for the construction of a particular sewer connecting No. .... Street and hereby agrees to comply with the Rules and Regulations governing the construction and use of Particular Sewers, as now or at any future time established by the Board of Selectmen.

Am't of estimate \$.....

Am't Paid \$.....

..... Owner

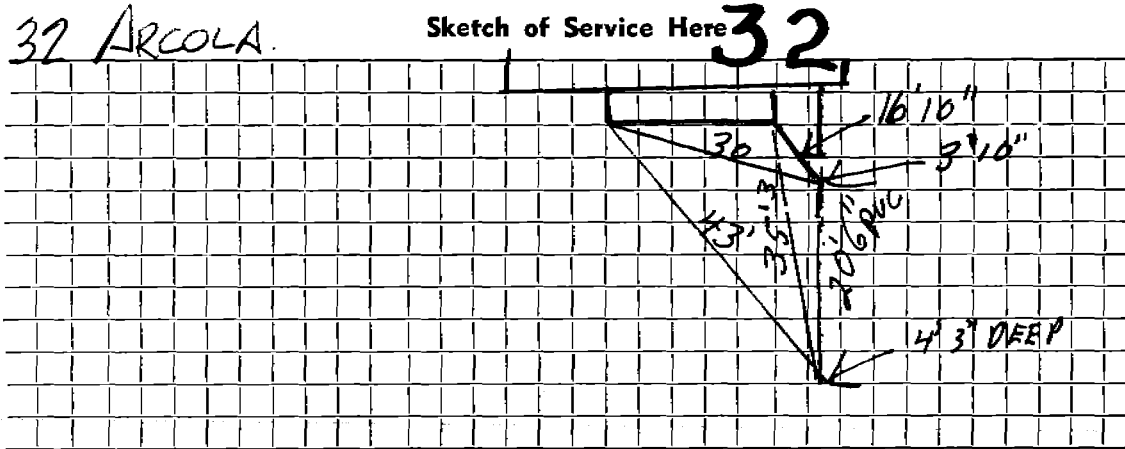

Connection made in ..... Street.

Work completed ..... 19..

Remarks: