

Name Francis Mahan

Service No. 91

Address 38 Arcola Street

Location

Kind of Pipe

Size

Size of Main

~~REPAIR WORK~~ New Service

Location

Cuma 8-1-60

Date	Material	Amount	Total	Date	Amount
6-9-60	Labor	51. 79		6-3-60	150 00
6-10-60	Labor	18 40		11-7-60	9 05
		70 19			159 05
	10% O.H.	7 02	77 21		
	53'6" Transite pipe @78		41. 34		
	5 Hrs. pippin shovel @4.50		22 50		
	2 Hrs. Trucking @3.00		6 00		
	1 Hr. Compressor @3.00		3 00		
	9 x 3 Patch		9 00		
			159 05		
	Labor				

TOWN OF LEXINGTON—DEPT. OF PUBLIC WORKS
SEWER DIVISION

DATE.....

NO.


The undersigned applies for the construction of a particular sewer connecting No.....
Street and hereby agrees to comply with the Rules and Regulations governing the construction and use of Particular
Sewers, as now or at any future time established by the Board of Selectmen.

Am't of estimate \$.....

Am't Paid \$.....

..... Owner

Sketch of Service Here

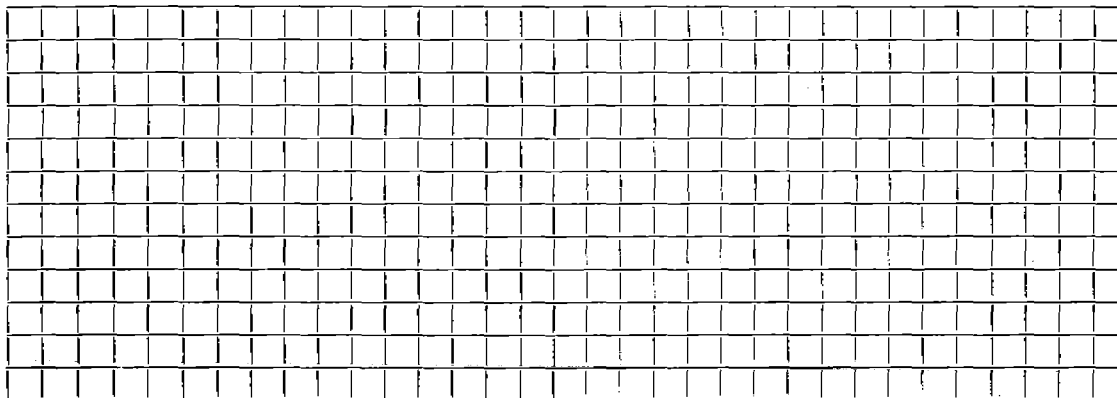

Connection made in..... Street.

Work completed.....19..

Remarks: