

Name Mary Garafola

Service No. 117

Address 39 Arcola Street, Lexington

Location Comm. 10-29-56

Kind of Pipe

Size

Size of Main

~~Repair~~ ~~Renewal~~ New Service

Location

Date	Material	Amount	Total	Date	Amount
8/23/56	Labor	18 28		8-21-56	Deposit \$160 00
	10% Overhead	1 83	20 11	10-29-56	Refund 116 39
	10'-6" Sewer Pipe @.455		4 55		43 61
	Joint Compound		1 20		
	2 hrs. Littlefield @ 8.50		17 00		
	1 hr. trucking @ .75		75		
			43 61		
				6/23/91	Flushed MAIN NO Blockage Rod Service NO Blockage WATER WILL NOT GO OUT
	Labor				

TOWN OF LEXINGTON—DEPT. OF PUBLIC WORKS

SEWER DIVISION

DATE.....

NO.

The undersigned applies for the construction of a particular sewer connecting No.....
 Street and hereby agrees to comply with the Rules and Regulations governing the construction and use of Particular
 Sewers, as now or at any future time established by the Board of Selectmen.


Am't of estimate \$.....

Am't Paid \$.....

..... Owner

39 ARCOLA

Sketch of Service Here

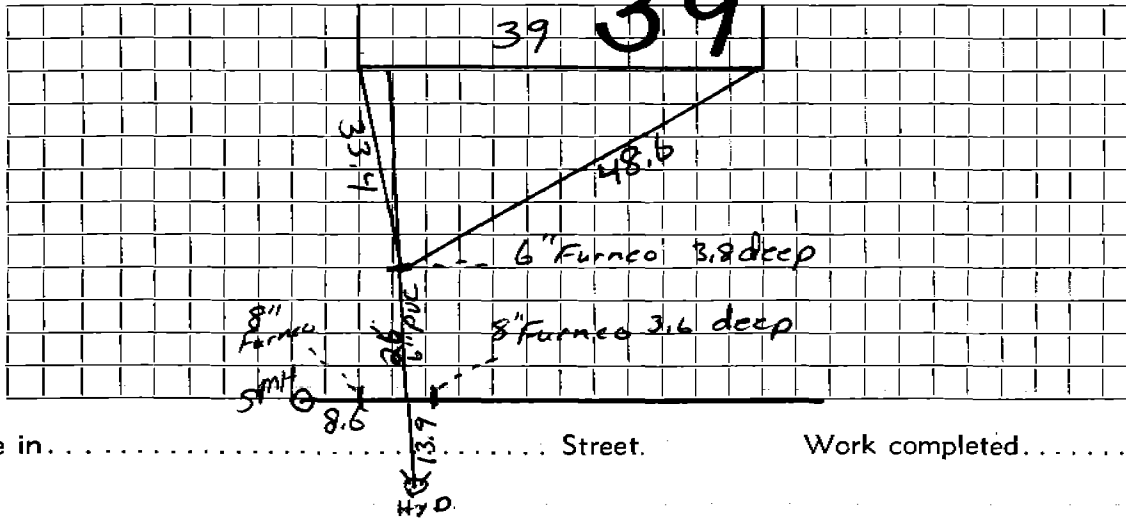

Connection made in..... Street.

Work completed..... 19..

Remarks: