




DATE \_\_\_\_\_

TOWN OF LEXINGTON — BOARD OF PUBLIC WORKS  
SEWER DIVISION

Sketch of Service Here

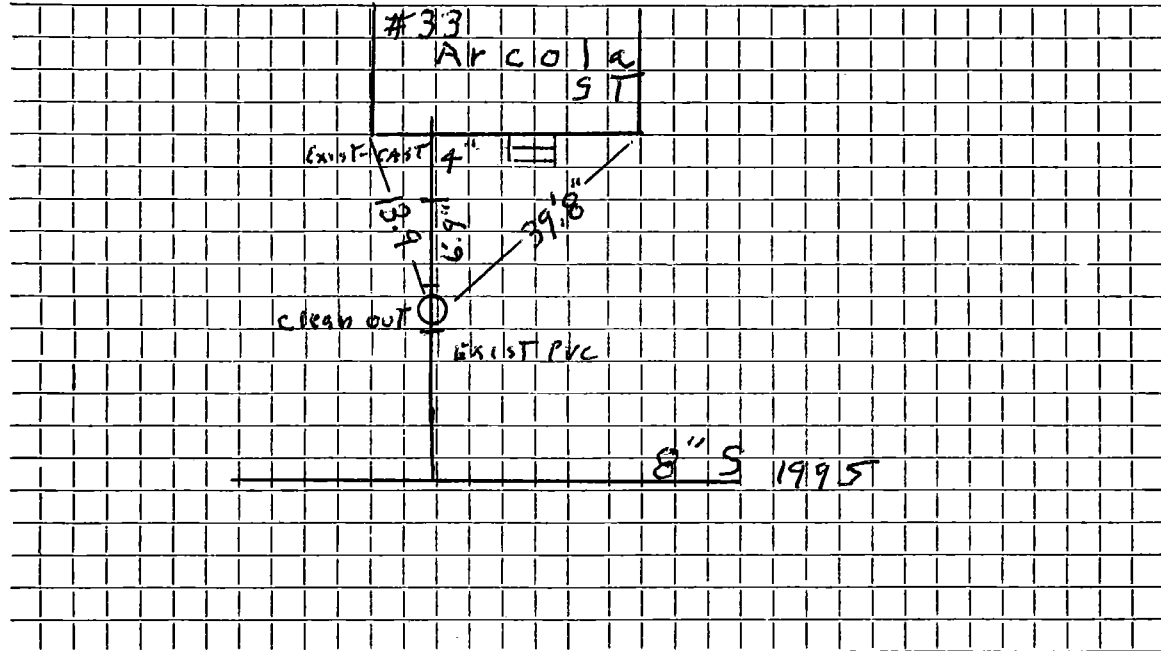

Connection made in Service - PVC ..... Street. Work completed 06/01/200.....

Remarks: Ins. Talled Clean Out.....  
Sewer MAIN Replaced - 1995.....