

Name: Chris Theodore

Service No. 164

Address

14 Asbury St.

Location

Kind of Pipe

Size

Size of Main

Repair—Renewal—New Service

5' Chimney - Old Excavating Corp.

#A 499

Location

156 Reed Street


Date	Material	Amount	Total		Date			Amount	
	20' 6" Transite pipe @3.50 installed by cont.		70	00	12-4-66	Deposit		70	00
12/6/66									
12/13/66	14' 6" Transite 10 1/4" Cast Iron								

DATE _____

TOWN OF LEXINGTON — BOARD OF PUBLIC WORKS
SEWER DIVISION

14

Sketch of Service Here

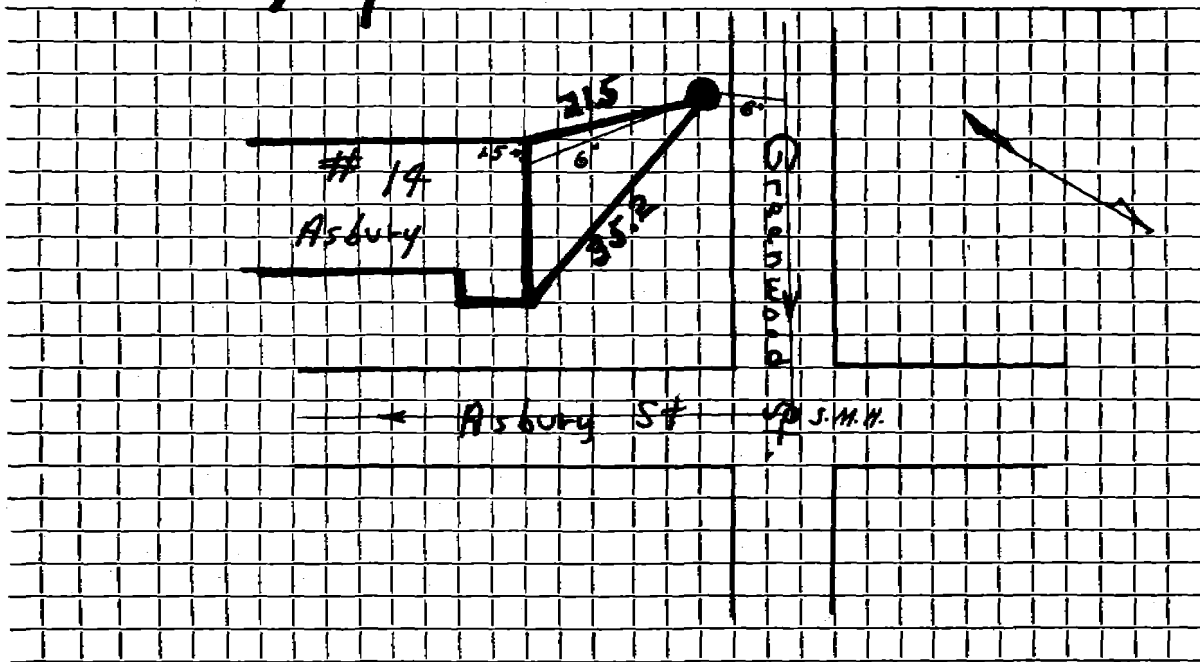

Connection made in Greenwood Street. Work completed

Remarks:
.....
.....