

Name **John J. Brisbois**

Service No. **3**

Address **32 Ashbury Street**      **Lots 279 - 282**

Location

Kind of Pipe

Size

Size of Main

~~XXXXXXXXXX~~ **New Service**      **Redmond #3777**

Location

**MAY 31 1983**


Date	Material	Amount	Total	Date	Amount
8-3-60	Labor	25.01		3-21-83	50.61
	10% O.H.	2.50	27.51		
	15' 6" Transite pipe @.78		11.70		
	1 6" Duplex Adapter		1.90		
	1 hr. Town Shovel @6.50		6.50		
	1 hr. Trucking @3.00		3.00		
	<b>BILL WHEN CONNECTED</b>		<b>50.61</b>		
3/24/83	53' P.V.C				
	1 Nye Clean-out 10' out				
	1 90° Elbow				
	1 45° Bend				

DATE 10/8/59

# TOWN OF LEXINGTON — BOARD OF PUBLIC WORKS SEWER DIVISION

TIES FOR HOUSE 32

32 Sketch of Service Here

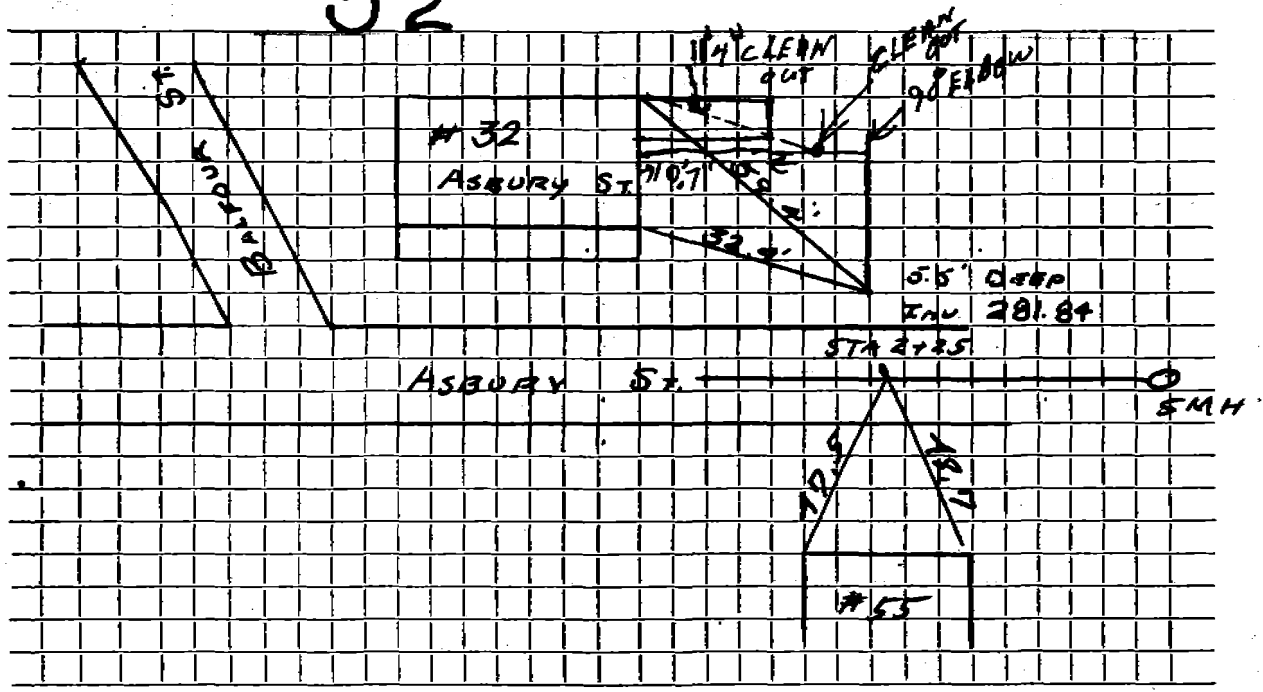

Connection made in ..... Street. Work completed .....

Remarks: .....  
.....  
.....