

Name James Gaudet

Service No. 236

Address 36 Asbury Street

Location

Kind of Pipe

Size

Size of Main

~~REPAIR~~ New Service

Location *Cen* 2-8-60


Date	Material	Amount	Total	Date	Amount
12-2-59	Labor	48 79		11-18-59	200 00
	10% O. H.	4 88	53 67	2-8-60	87 98
	48 6" Transite pipe @.70		33 60		112 02
	5 Hrs. Pippin Shovel @1.50		22 50		
	3 Hrs. Trucking @.75		2 25		
			112 02		

DATE 10/8/59

TOWN OF LEXINGTON — BOARD OF PUBLIC WORKS  
SEWER DIVISION

36

Sketch of Service Here

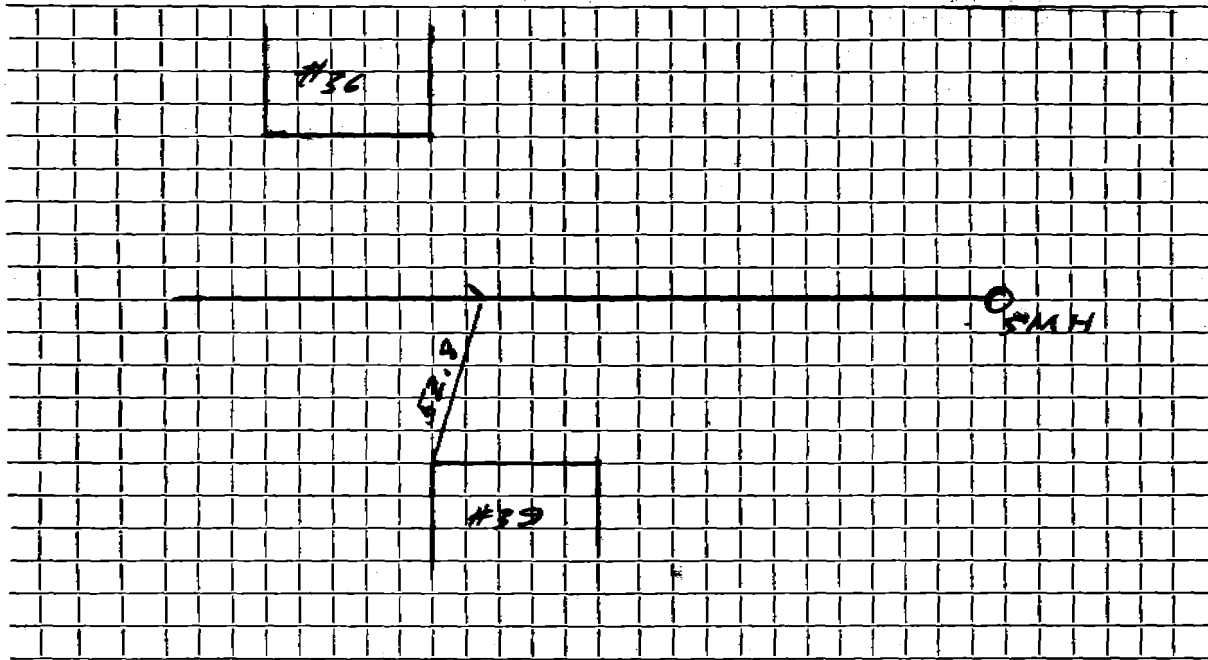

Connection made in ..... Street. Work completed .....

Remarks: .....  
.....  
.....