

1977

Name **Walter A. Stalter**

Service No. 8

Address **41 Asbury Street**

Lots **537 - 539**

JUN 20 1977

Location

Kind of Pipe

Size

Size of Main

~~Repair~~ **New Service** Valeri Construction #3260

Location

Date	Material	Amount	Total	Date	Amount
8-4-60	Labor	53.53		3/30/77	97.26
	10% O.H.	5.35	58.88		
	20' 6" Transite pipe @.78		15.60		
	1 6" Duplex Adapter		1.90		
	1 6" Clay Elbow		1.88		
	2 hrs. Town Shovel @6.50		13.00		
	2 hrs. Trucking @3.00		6.00		
	BILL WHEN CONNECTED		97.26		
4-6-77	10' 4" C.I.				
	9' 6" A.C.P.				


DATE _____

TOWN OF LEXINGTON — BOARD OF PUBLIC WORKS

SEWER DIVISION

41

Sketch of Service Here

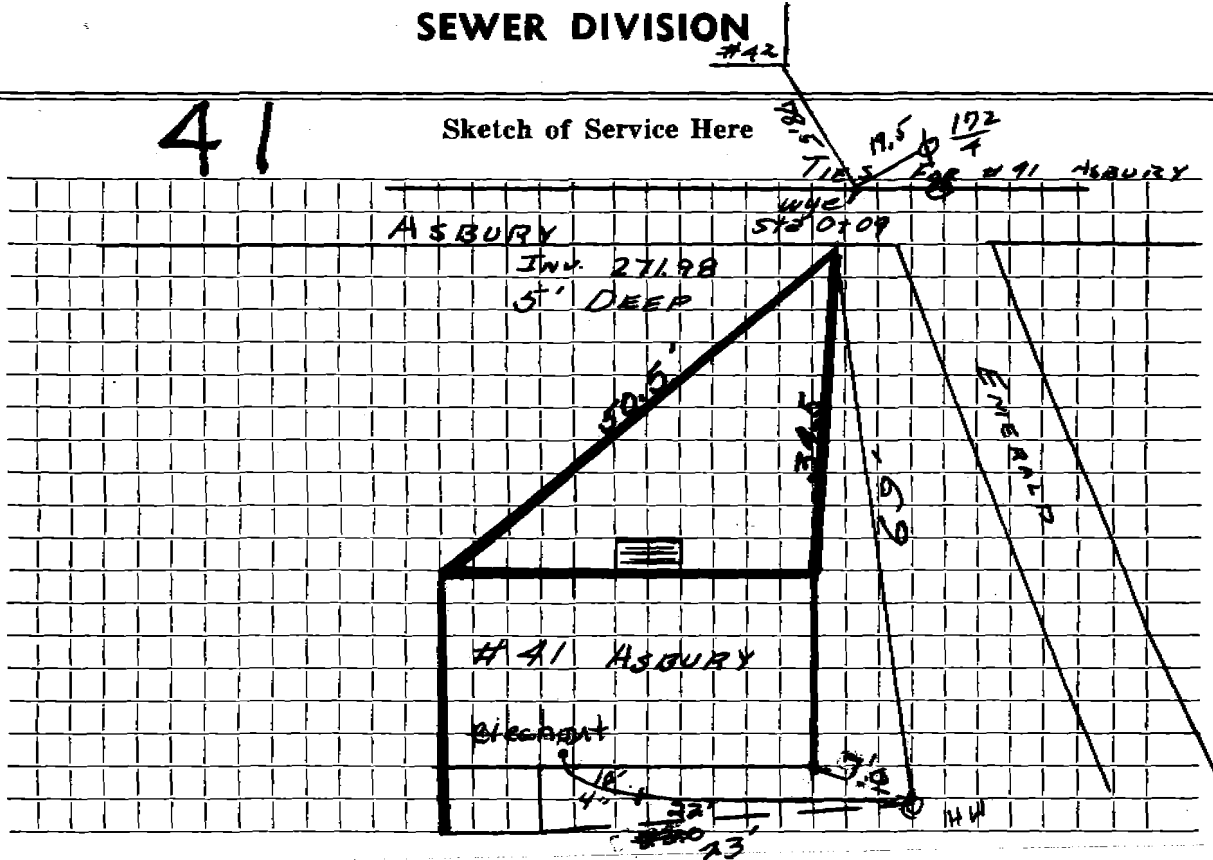

Connection made in Street. Work completed

Remarks:

.....

.....