




DATE 10/8/59

# TOWN OF LEXINGTON — BOARD OF PUBLIC WORKS SEWER DIVISION

Sketch of Service Here

42 TIES FOR # 42 ASBURY

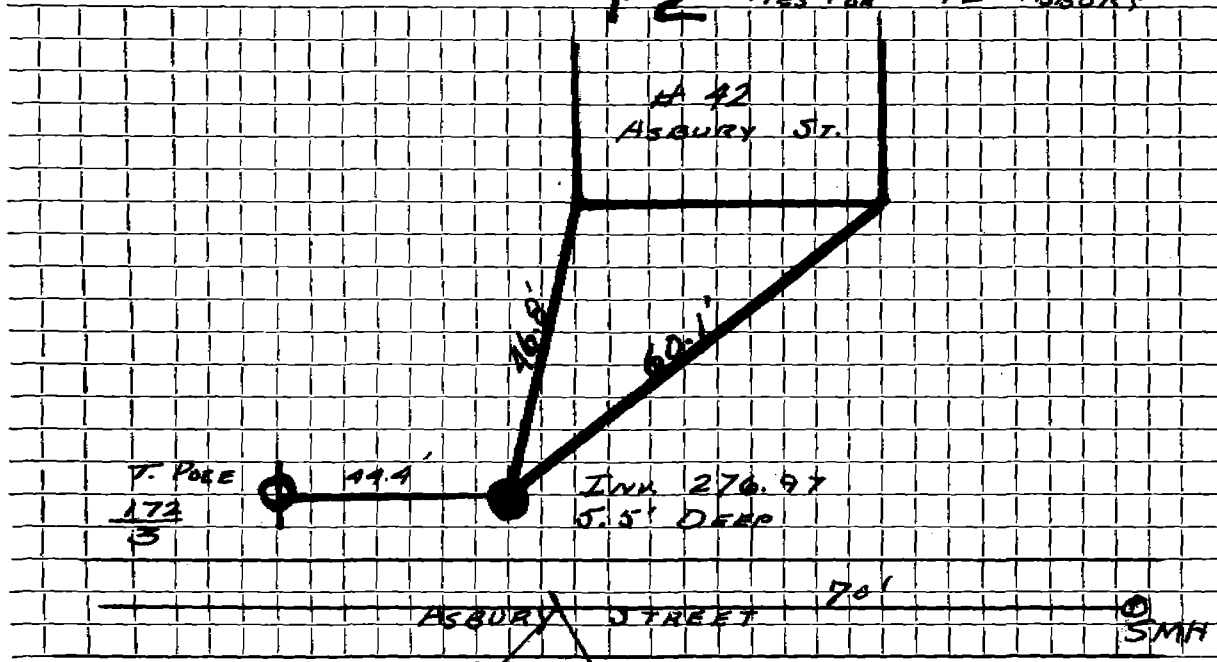

Connection made in ..... Work completed .....

Remarks: .....  
.....  
.....