


DATE 8/18/03

TOWN OF LEXINGTON — BOARD OF PUBLIC WORKS
SEWER DIVISION

Sketch of Service Here
45 ASBURY

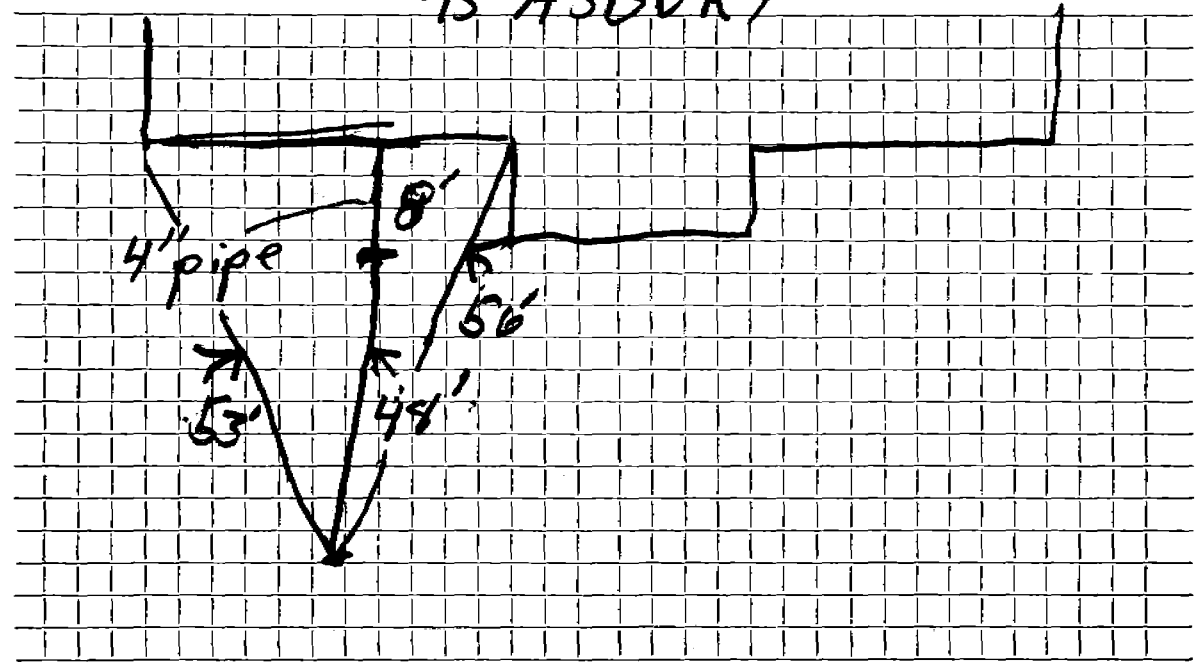

Connection made in Street. Work completed

Remarks:

