

Name William Hamilton

Service No. 155

Address 46 Asbury Street

Location

Kind of Pipe

Size

Size of Main

~~Rapak-Ranzak~~ - New Service

Location

Conn 11-16-59


Date	Material	Amount	Total	Date	Amount
8-31-59	Labor	40 22		8-28-59	50 00
9-1-59	"	8 66		12-22-59	45 82
		48 88			95 82
	10% O. H.	4 89	53 77		
	5 1/2" 6" Transite pipe @.70		37 80		
	1 6" Clay Elbow		1 88		
	2" 6" pipe @.435		87		
	2 Hrs. Trucking @.75		1 50		
			95 82		

Bill sent 11-2-59 46 82

DATE \_\_\_\_\_

**TOWN OF LEXINGTON — BOARD OF PUBLIC WORKS**  
**SEWER DIVISION**

Sketch of Service Here

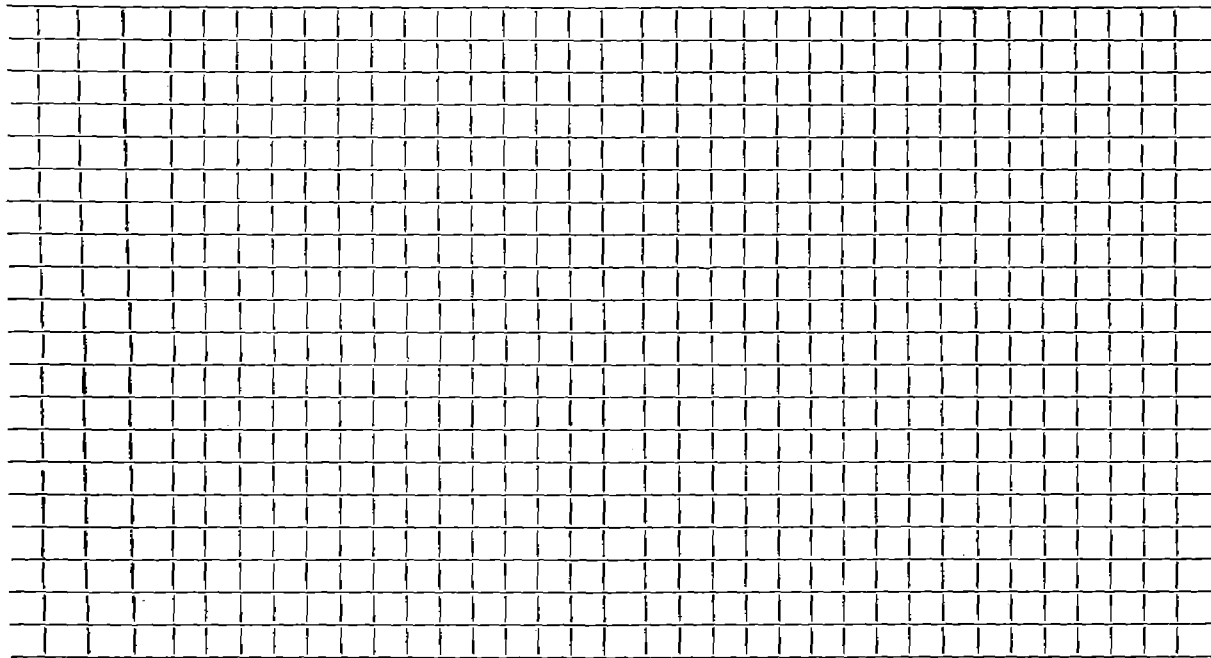

Connection made in ..... Street.      Work completed .....

Remarks: .....  
.....  
.....