

Name Mrs. Joseph Sheehan

Service No. 60

Address ~~52~~
64 Asbury Street

Location

Kind of Pipe

Size

Size of Main

~~Repair~~ ~~Renewal~~ New Service

Location *Unit 1-22-59*


Date	Material	Amount	Total	Date	Amount
5-26-59	Labor 8h.13			5-12-59	Deposit 150.00
5-28-59	Labor 26.13	107.26		5-22-59	Paid by W.H.H. 88 14.79
	10% O.H.	10.73	117.99		Paid 50.25
72'	6" Transite pipe @.70		50.40		215.04
2	22½° Transite Bends @6.21		12.42		
1	6" Clay Elbow		1.88		
2	22½° Transite Elbows @2.24		4.48		
2'	6" Clay Pipe @.435		.87		
3	hrs. Town Shovel @6.50		19.50		
2	hrs. Trucking @.75		1.50		
1	hr. Trucking @3.00		3.00		
1	hr. Trailer @3.00		3.00		
			215.04		

Bill 500 - 2.5 - 53

DATE _____

TOWN OF LEXINGTON — BOARD OF PUBLIC WORKS
SEWER DIVISION

52 Sketch of Service Here

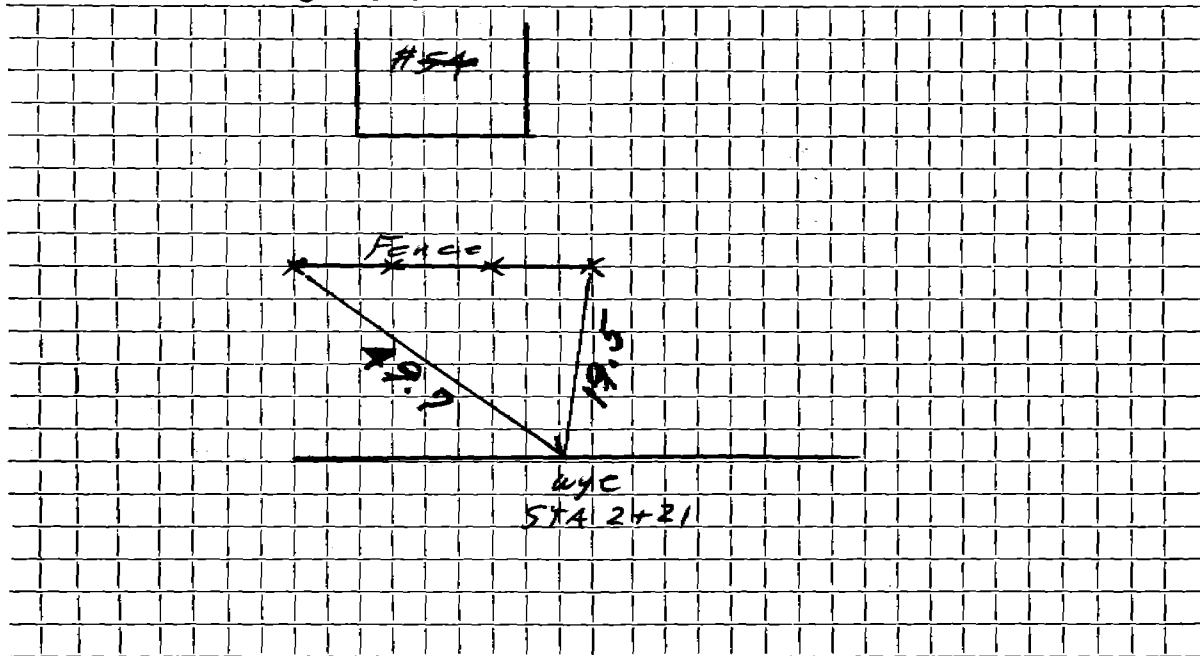

Connection made in Street. Work completed

Remarks:
.....
.....