

Name Foley Construction Co.

Service No. 152

Address ~~54~~ 58 Asbury Street

Lots 254 - 258

Location

Kind of Pipe

Size

Size of Main

~~Repair - Renewal~~ New Service DeFlice Bros. Permit #91

Location DEC 28 1964

Date	Material	Amount	Total	Date	Amount
8-6- & 8-60	Labor	82.48		9-9-64	130.31
	10% O.H.	8.25	90.73	Deposit	
20'	6" Transite pipe @.78		15.60		
1	6" Clay Elbow		1.88		
3	hrs. Town Shovel @6.50		19.50		
1	hr. Trucking @3.00		3.00		
	BILL WHEN CONNECTED		130.31		
9-30-64	35' 6" Transite pipe				


DATE _____

TOWN OF LEXINGTON — BOARD OF PUBLIC WORKS
SEWER DIVISION

54

Sketch of Service Here

TICKS FOR ~~450~~ ⁵⁴ ASBURY

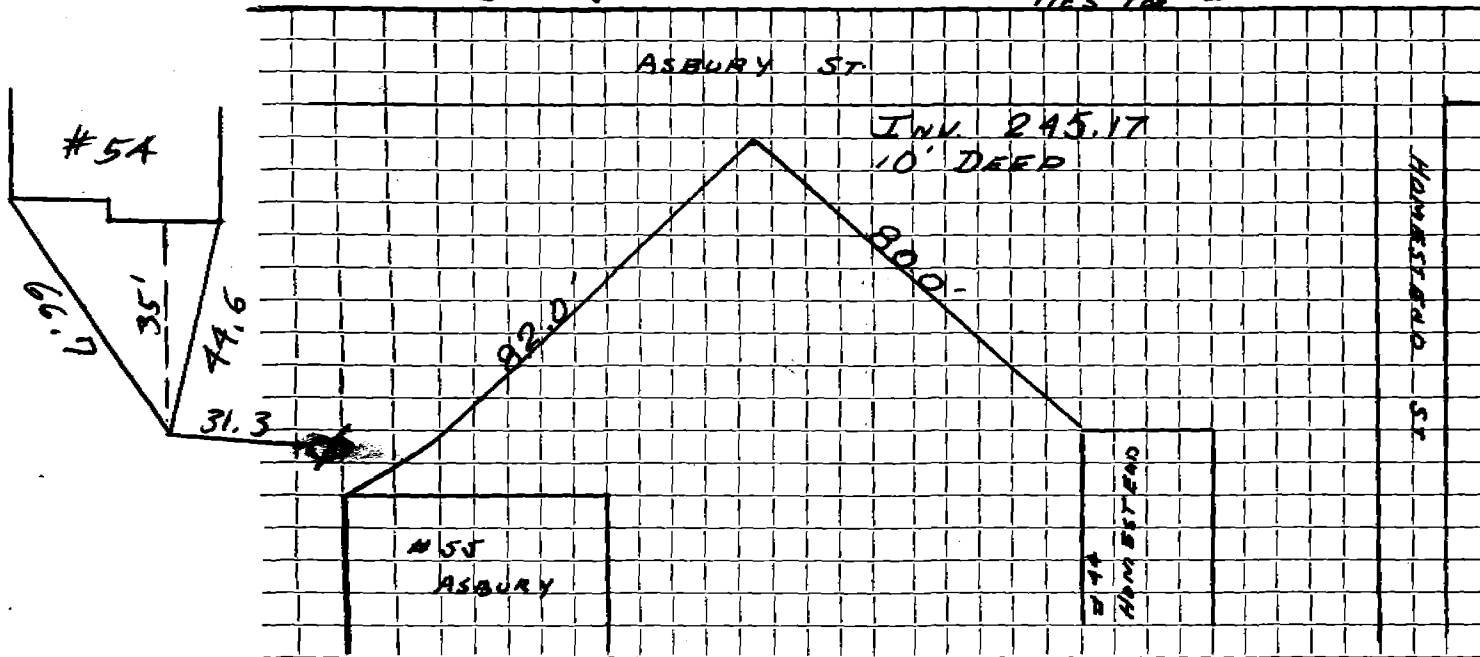

Connection made in Street. Work completed

Remarks:

.....

.....