

Name : Tricorn Homes

Service No. 6

Address 64 Asbury Street

Lot 253 - 249

Location

Kind of Pipe

Size

Size of Main

~~Repair Renewal~~ New Service

WO # 8534

Location

Comm 5-18-64

Date	Material	Amount	Total	Date	Amount
8-6 & 8-60	Labor	100.05		1-20-64	Deposit 200.00
	10% O.H.	10.01	110.06	5-18-64	Paid by WHT #3 13.29
	35' 6" Transite pipe @.78		27.30	6-5-64	Paid 24.73
	2 hrs. Town Shovel @6.50		13.00		238.02
	1 hr. Trucking @3.00		3.00		
	2 hrs. Compressor @3.00		6.00		
	BILL WHEN CONNECTED		159.36		
4-2-64	Labor	31.62			
	10% O.H.	3.16	34.78		
	42' 6" Transite Pipe @.82		34.44		
	1 11 $\frac{1}{4}$ " Transite Elbow		2.35		
	1 11 $\frac{1}{4}$ " Transite Bend		4.09		
	1 Hr. Trucking @3.00		3.00		
			238.02		
					B. Sec 2473

DATE _____


TOWN OF LEXINGTON — BOARD OF PUBLIC WORKS

SEWER DIVISION

TICKS FOR ~~62~~ 64 ASBURY STREET

64

Sketch of Service Here

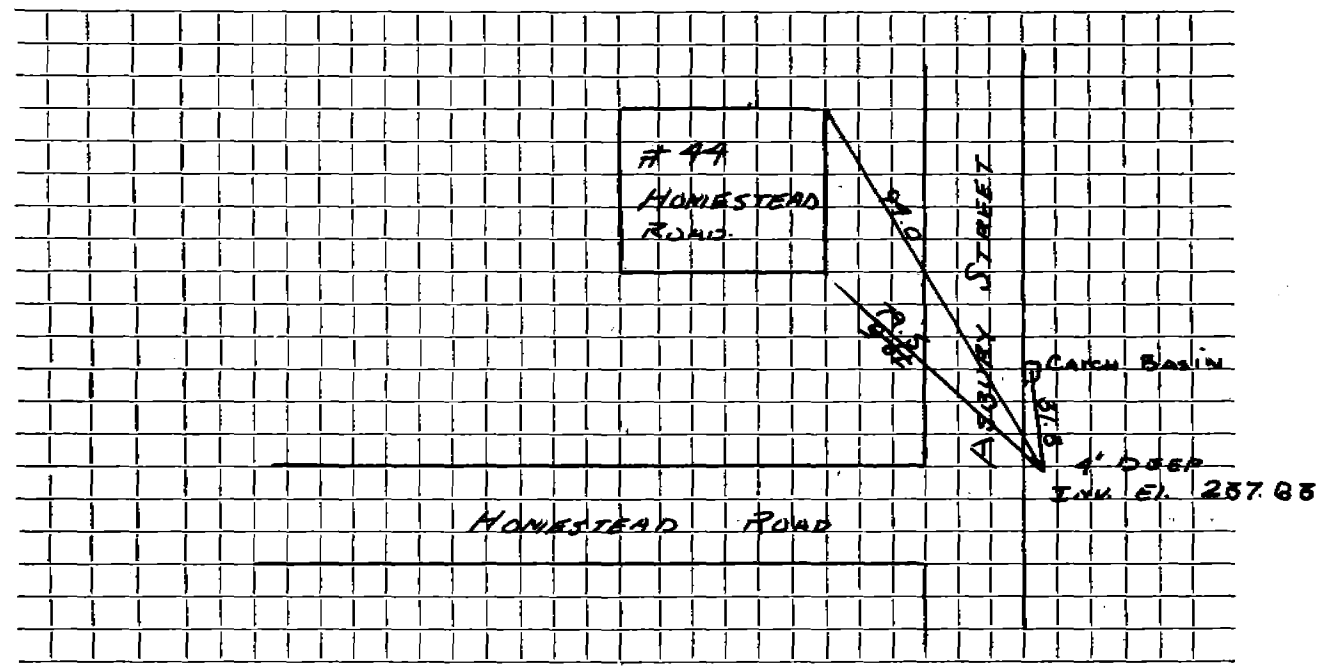

Connection made in Street. Work completed

Remarks:
.....
.....