




DATE \_\_\_\_\_

TOWN OF LEXINGTON — BOARD OF PUBLIC WORKS  
SEWER DIVISION

67

Sketch of Service Here

TIE FOR #67 ASBURY

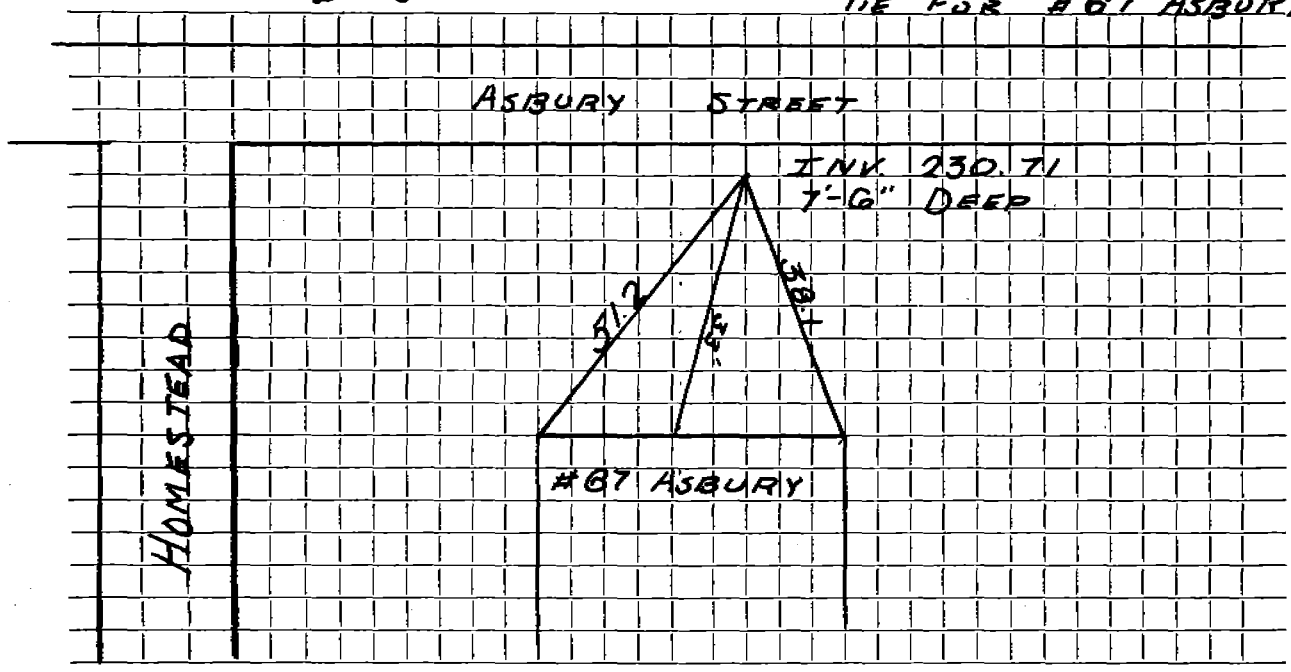

Connection made in ..... Street. Work completed .....

Remarks: .....  
.....  
.....