

Name William Sullivan

Service No. 126

Address 68 Asbury Street Lot 243 - 248

Location

Kind of Pipe

Size

Size of Main

~~REPAIR~~ New Service Sibley #816

Location *Cambridge*

Date		Material	Amount	Total	Date	Amount
8-5-60		Labor	45.37		10-2-67	84.97
		10% O.H.	4.54	49.91	<i>Deposit</i>	
	22'	6" Transite pipe @.78		17.16		
	1	6" Adapter		1.90		
	2	hrs. Town Shovel @6.50		13.00		
	1	hr. Trucking @3.00		3.00		
		BILL WHEN CONNECTED		84.97		
10-16-67	52'	6" Transite pipe				
	10'	4" Cast Iron pipe				

DATE _____


TOWN OF LEXINGTON — BOARD OF PUBLIC WORKS

SEWER DIVISION

TIES FOR 68 ASBURY

68

Sketch of Service Here

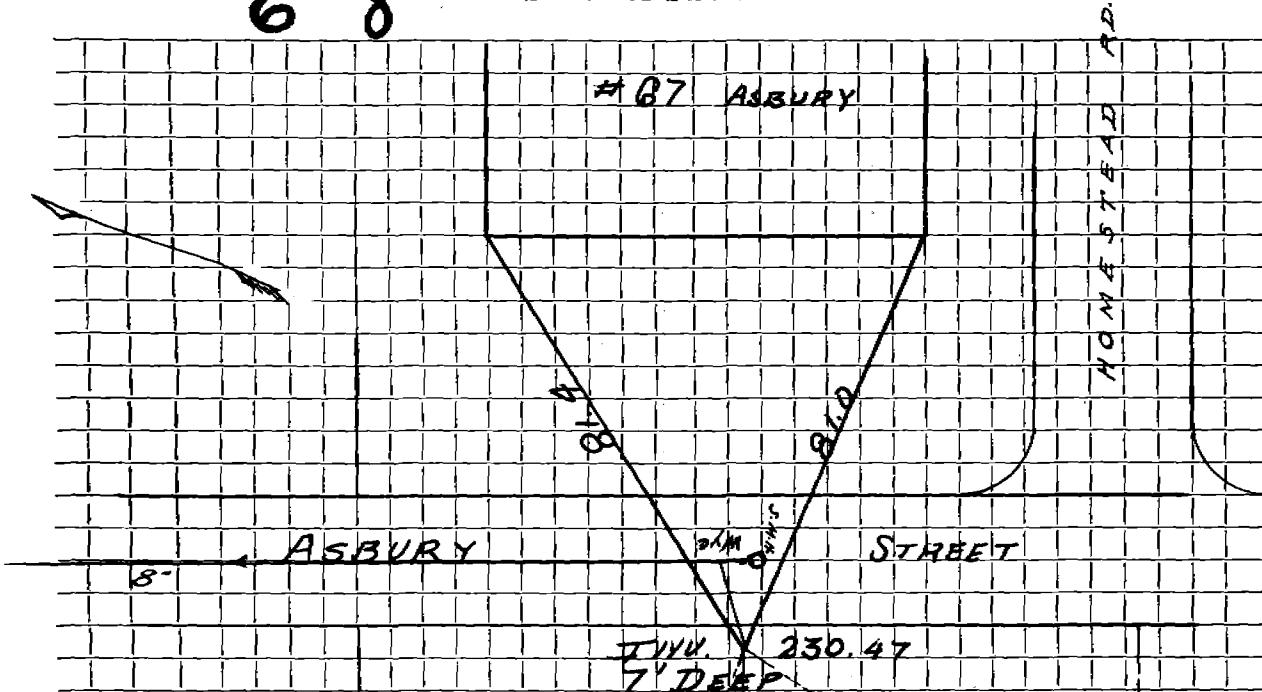

Connection made in Street.

Remarks:

Lot 244

68

Lot 248

Work completed