

Name **W. E. Neville**

Service No. **77**

Address **7 Asbury Street**

Location

Kind of Pipe

Size

Size of Main

~~XXXXXXXXXXXX~~ **New Service**


Location *Comm 8-3-59*

Date	Material	Amount	Total	Date	Amount
1959	21' Transite pipe @3.50 per ft. installed by contractor		73.50	6-5-59 4-21-61	150.00 20.36
6-8-59	Labour 10% O.H.	51.10 5.11	56.21		170.36
	32' 6" Transite pipe @.70		22.40		
	2 hrs. Town Shovel @6.50		13.00		
	2 hrs. Trucking @.75		1.50		
	1 hr. Rodgers Trailer @3.00		3.00		
	1 hr. Trucking @.75		<u>.75</u>		
			<b>170.36</b>		
				<i>Bill sent 8-3-59</i>	<i>20.36</i>

DATE \_\_\_\_\_

**TOWN OF LEXINGTON — BOARD OF PUBLIC WORKS**  
**SEWER DIVISION**

Sketch of Service Here

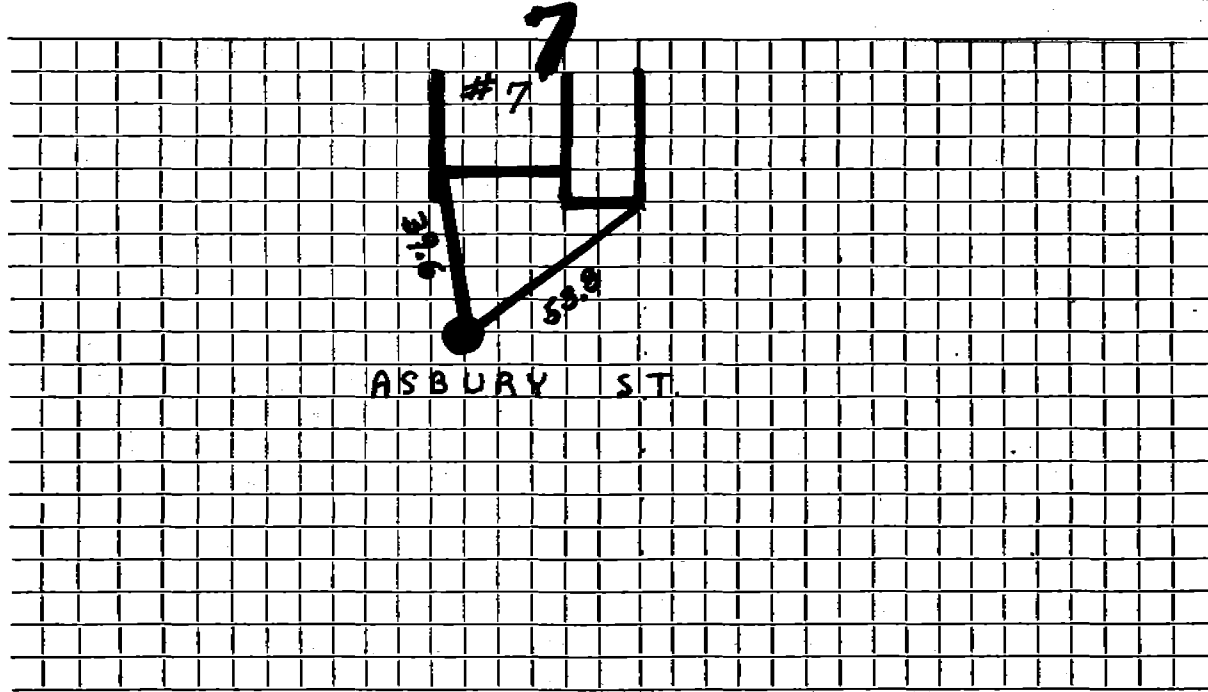

Connection made in ..... Street. Work completed .....

Remarks: .....  
.....  
.....