

Name MRS. CHAN

Service No.

Address # 71 ASBURY STREET

Location

Kind of Pipe

Size

Size of Main

Repair Renewal New Service

PERMIT NO. 0832 *Rockwell*

Location


Date		Material	Amount	Total	Date		Amount
7/20	96	31' - 6" P.V.C. 6"X6" FERNCO					
					4-8-	60	
						52'	6" Transite
						1	6"-90° Transite Elbow
					1-30-	96	Plumber say problem in ST. Area. Respond + Measure.
					4-9-	96	Homeowners Responsible 24' + 56'

DATE 20 JULY 1996

TOWN OF LEXINGTON — BOARD OF PUBLIC WORKS
SEWER DIVISION

71

Sketch of Service Here

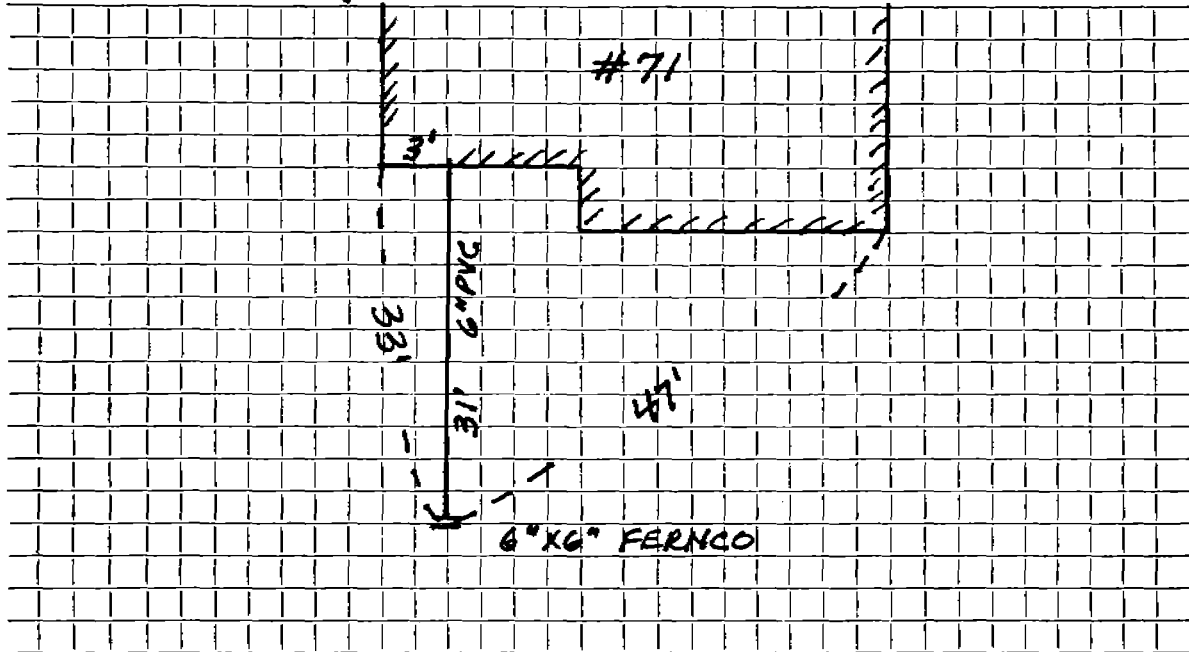

Connection made in ASBURY STREET Street.

Work completed ROCKWELL CONSTRUCTION

Remarks:

BOOK 96-3