


DATE _____

TOWN OF LEXINGTON — BOARD OF PUBLIC WORKS
SEWER DIVISION

6

Sketch of Service Here

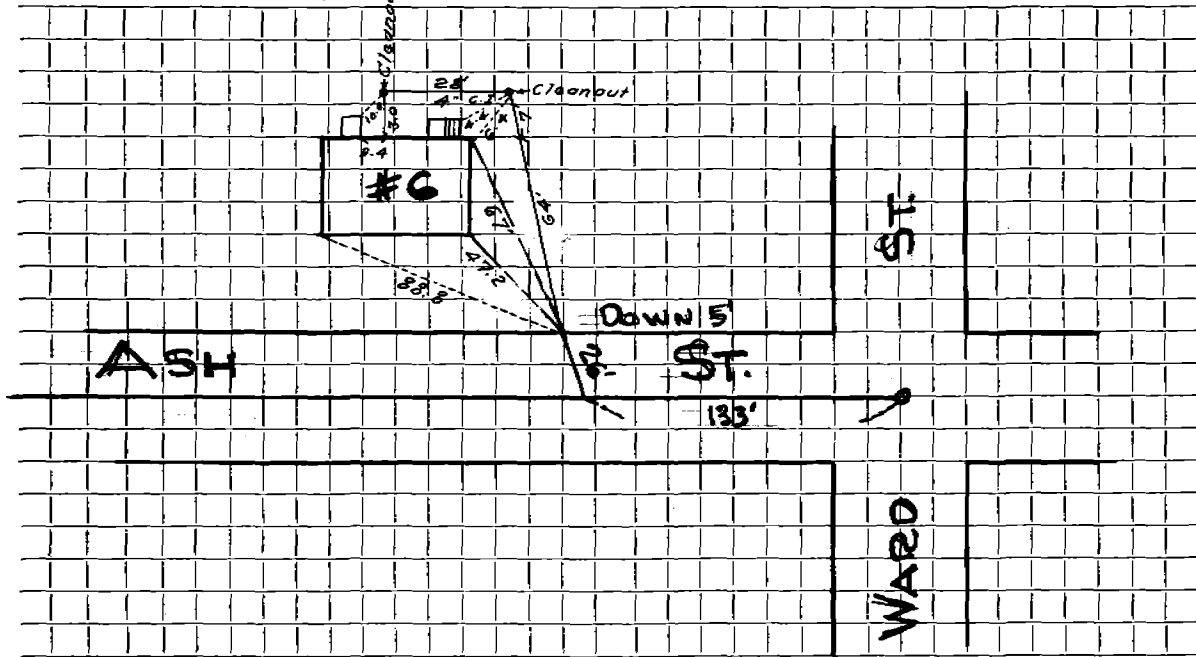

Connection made in Street. Work completed

Remarks:
.....
.....