

Name Merle Miller
 Address 194 Mt. Vernon Street, Malden, Mass.

Service No. 5 22

Location 10 Audubon Road, Lexington, Mass.

Kind of Pipe

Size

Size of Main

~~Repair~~—Renewal—New Service

Location

Date	Material	Amount	Total	Date	Amount
May 23, 1939	34½ hrs. @ 55¢	18 98		May 1, 1939	70 00
30m 7-17-39	9 " @ 60¢	5 40		July 24, 1939	2 82
	9 " @ 70¢	6 30	30 68 ✓		67 18
	10% Overhead		3 07 ✓		
	40' 6" Sewer Pipe @ 20¢		8 00 ✓		
	1 1/8-6" Bend		65 ✓		
	1 6 x 4 Reducer		1 00 ✓		
	Joint Compound		2 40 ✓		
	1 hr. Compressor		3 00 ✓		
	2 hrs. Trucking @ 75¢		1 50 ✓		
	Trench Repairs.		16 88 ✓		
			67 18		
	Labor				

TOWN OF LEXINGTON—BOARD OF PUBLIC WORKS

SEWER DIVISION

DATE April 29/39

NO. _____
Audubon Rd.


The undersigned applies for the construction of a particular sewer connecting No. Audubon Rd. Street and hereby agrees to comply with the Rules and Regulations governing the construction and use of Particular Sewers, as now or at any future time established by the Board of Selectmen.

Am't. of Estimate \$ 75.00

Am't. Paid \$ _____

Marle Miller Owner

10 Sketch of Service Here

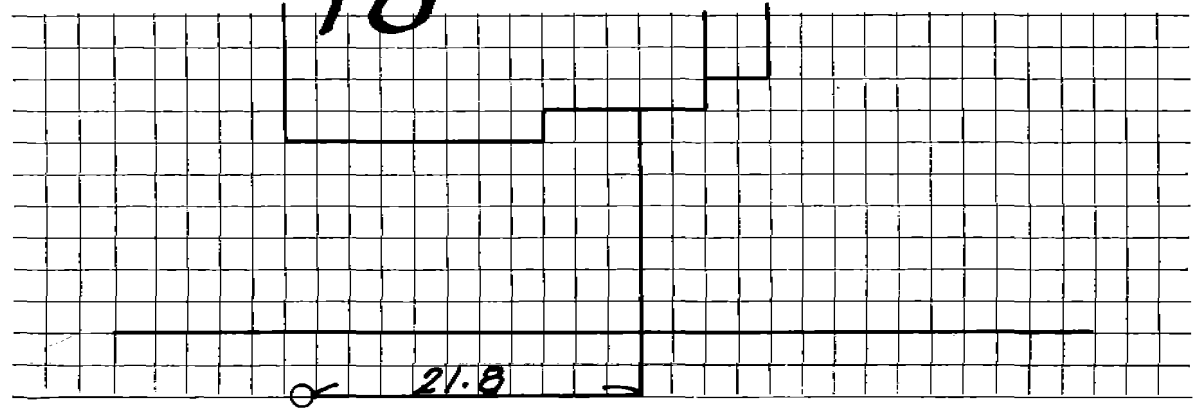

Connection made in _____ Street.

Work completed _____ 19

Remarks: