

Name **Elmer A. Chadwick**
 Address **17 Audubon Road**

Service No. **29 25**

Location

Kind of Pipe

Size

Size of Main

~~Repair - Renewal~~ **New Service**

Location

Date	Material	Amount	Total	Date	Amount
<i>P. 9-18-28 for 89.53</i>	57' 6" Sewer Pipe @.30	17 10		<i>Oct. 16 1928 - Cash</i>	<i>89 53</i>
	1 6" Bend	70			
	Sulphur & Jute	2 28			
	Trucking	75			
	1 Bag Cement	70			
	1 Pc. 30" Sewer Pipe	<u>8 00</u>	29 53		
<i>7/18/28</i>	90 Hrs. Labor @.55	49 50			
	3 " " @.60	<u>1 80</u>	51 30		
	15% Overhead		<u>8 70</u>		
			<u>89 53</u>		
	Labor				

Hadley Press, Inc. Lexington

Sup. 0723M.

TOWN OF LEXINGTON—BOARD OF PUBLIC WORKS
SEWER DIVISION

DATE May 5, 1928

NO. _____


The undersigned applies for the construction of a particular sewer connecting No. 17 Audubon Road Street and hereby agrees to comply with the Rules and Regulations governing the construction and use of Particular Sewers, as now or at any future time established by the Board of Selectmen.

Am't. of Estimate \$ _____

Am't. Paid \$ _____

Elmer A. Chadwick Owner
H.P.C.

Sketch of Service Here

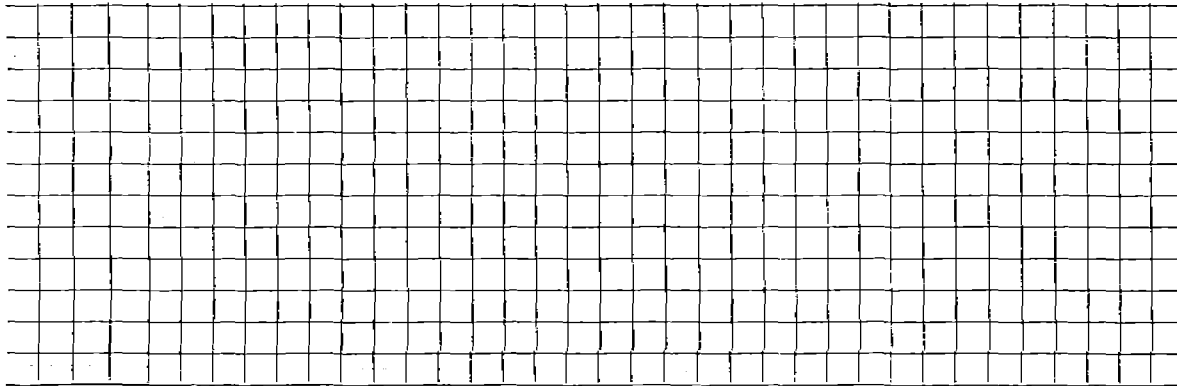

Connection made in _____ Street.

Work completed _____ 19

Remarks: