




DATE Oct 17, 1983

TOWN OF LEXINGTON — BOARD OF PUBLIC WORKS  
SEWER DIVISION

Sketch of Service Here **9**

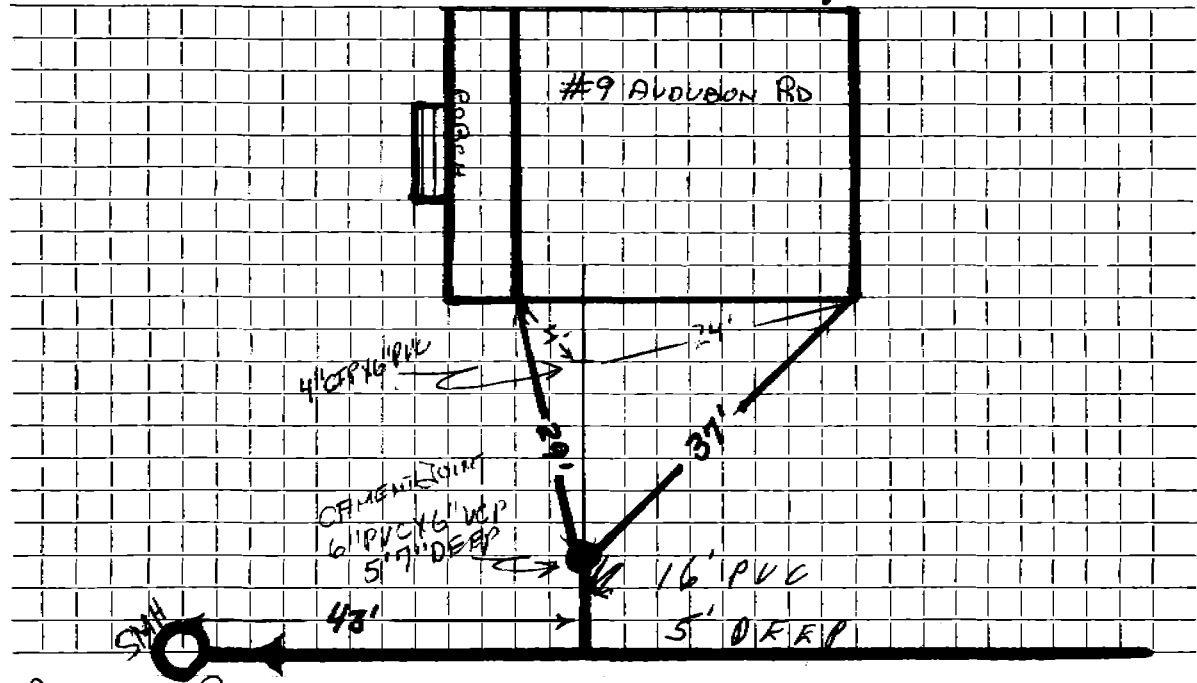

Connection made in AUDUBON RD Street. Work completed .....

Remarks: .....  
.....  
.....