

Name

Service No.

Address

11 Augustus Road

Location

Kind of Pipe

Size

Size of Main

~~Water Removal~~ New Service

Pond Realty

Location

Date

Material

Amount

Total

Date

Amount

1964


61'

6" Transite pipe

DATE \_\_\_\_\_

**TOWN OF LEXINGTON — BOARD OF PUBLIC WORKS**  
**SEWER DIVISION**

Sketch of Service Here **//**

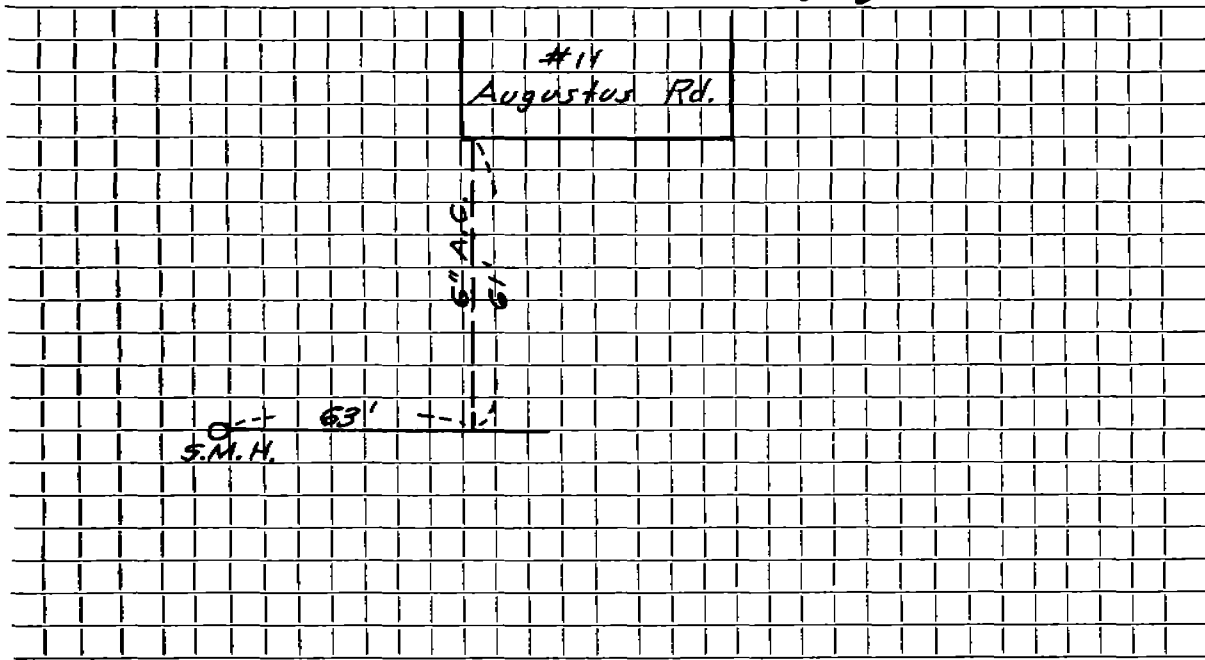

Connection made in ..... Street. Work completed .....

Remarks: .....  
.....  
.....