

Name

Service No.

Address 15 Augustus Road

Location

Kind of Pipe

Size

Size of Main

~~Repair & Renewal~~ New Service Pond Realty

Location

Date

Material

Amount

Total

Date

Amount


63' 54' 6" Transite pipe @

DATE \_\_\_\_\_

**TOWN OF LEXINGTON — BOARD OF PUBLIC WORKS**  
**SEWER DIVISION**

Sketch of Service Here

**15**

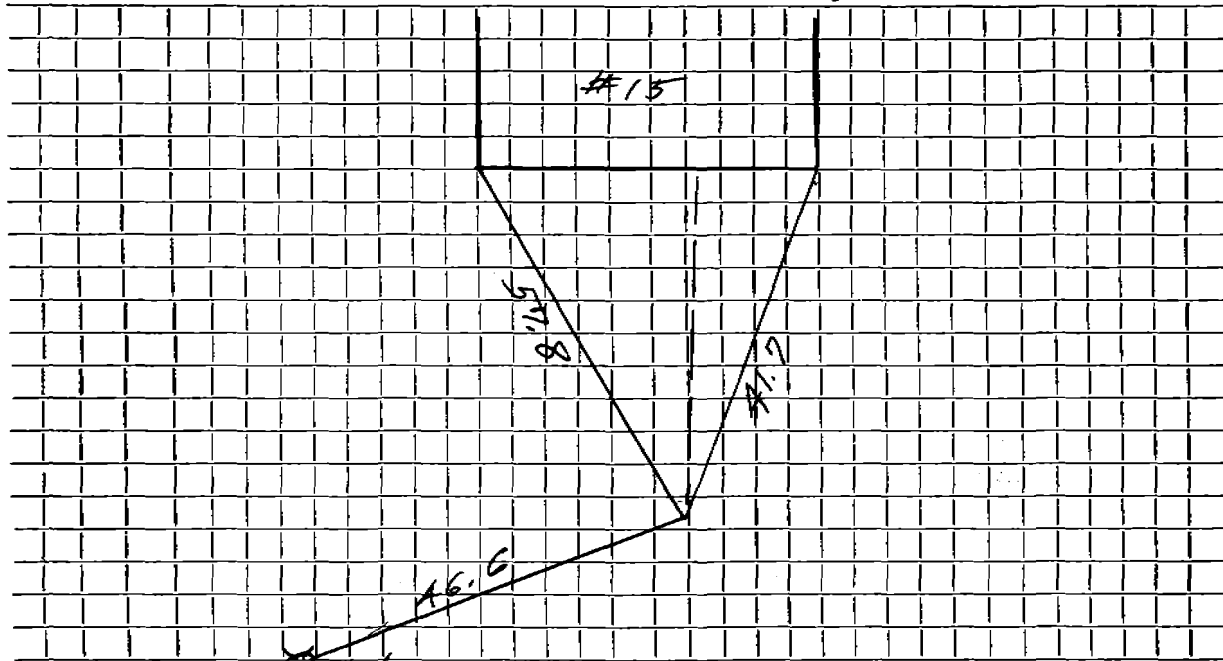

Connection made in ..... Street. Work completed .....

Remarks: .....  
.....  
.....