

Name

Service No.

Address 17 Augustus Road

Location

Kind of Pipe

Size

Size of Main

~~Service~~ **New Service Pond Realty**

Location

Date

Material

Amount

Total

Date


Amount

1964 58' 6" Trm site pipe

DATE _____

TOWN OF LEXINGTON — BOARD OF PUBLIC WORKS
SEWER DIVISION

Sketch of Service Here **17**

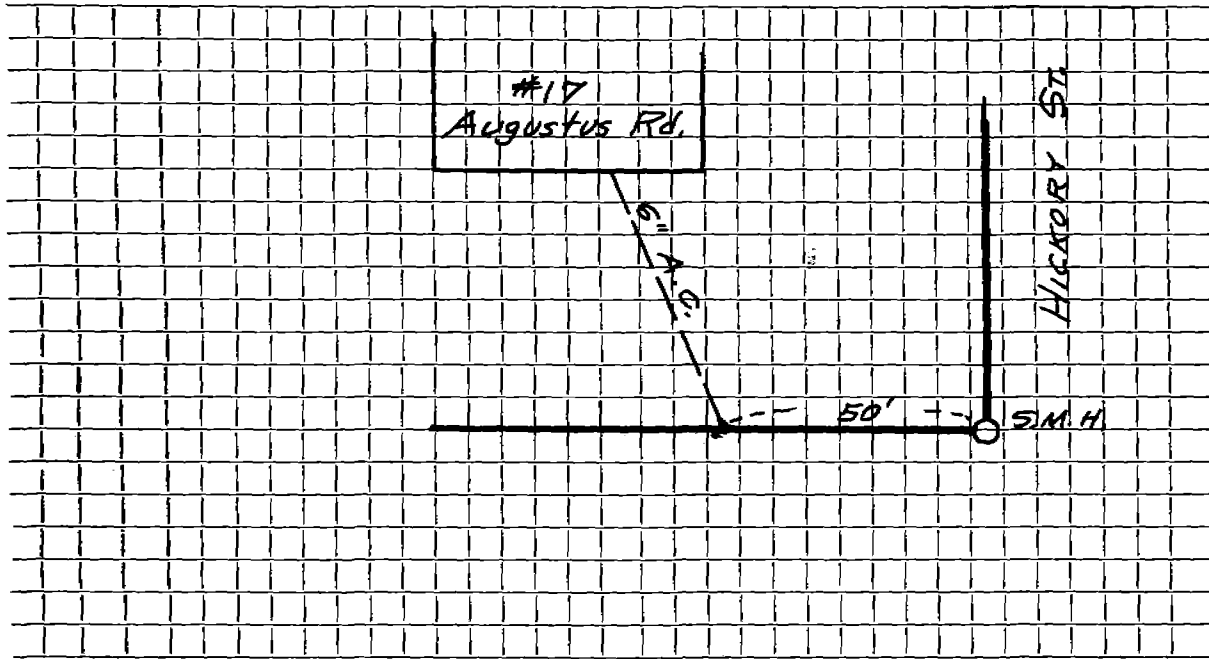

Connection made in Street. Work completed

Remarks:
.....
.....