


DATE _____

TOWN OF LEXINGTON — BOARD OF PUBLIC WORKS
SEWER DIVISION

Sketch of Service Here

19

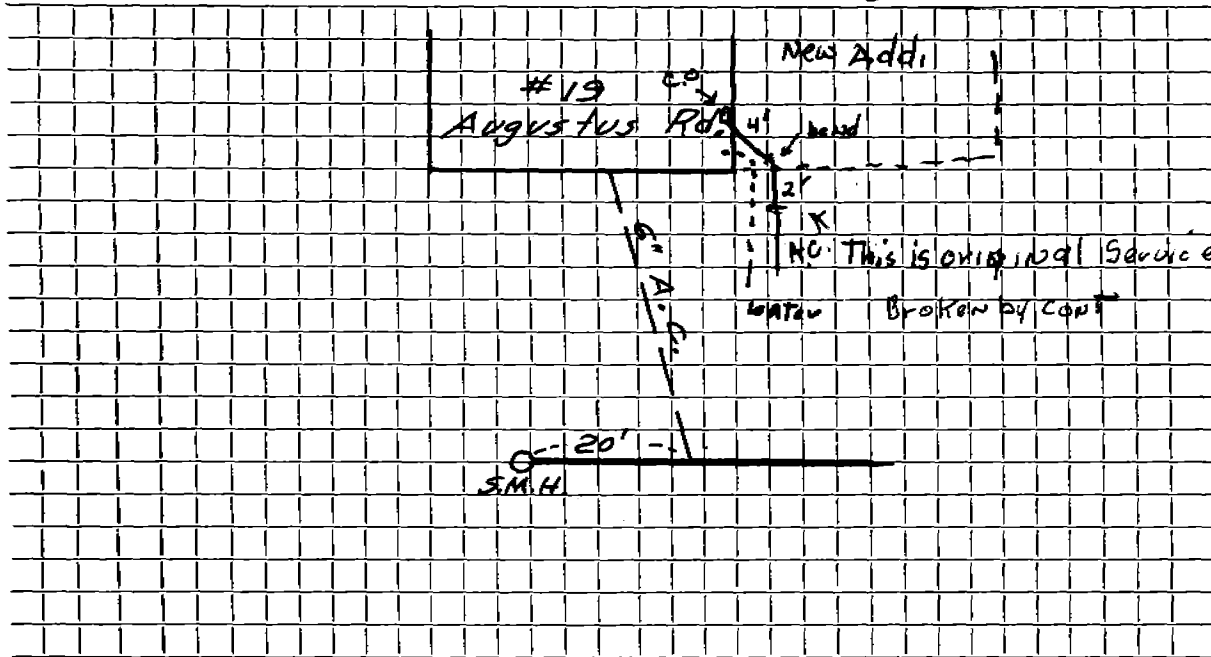

Connection made in Street. Work completed

Remarks: Sewer under new footing. Cleanout in garage. 4" cast iron. Bend is 3'8" from corner of exist house