

Name Cont: JM McLaughlin

Service No.

Address 4 Augustus Rd

Location

Kind of Pipe SDR35 6" PVC

Size 6"

Size of Main

Repair—Renewal—New Service

Location


Date	Material	Amount	Total	Date	Amount
7-16-17	4" SDR21 PVC	10'			
	6" x 4" FernCo				
	6" SDR35 PVC	1'			
	6" cleanout				
	6" PVC pipe	14'			
	11° Bend 6"				
	6" PVC pipe	28'			
	11° Bend 6"				
	6" PVC pipe	14'			
	6" cleanout				
	6" PVC pipe	14'			
	22° bend				
	11° bend				
	6" PVC pipe	19'			
	22° bend				
	6" PVC to 6" AC FernCo to stub	depth = 5'4"			

DATE 7/16/17

TOWN OF LEXINGTON — BOARD OF PUBLIC WORKS  
SEWER DIVISION

Sketch of Service Here

# 4

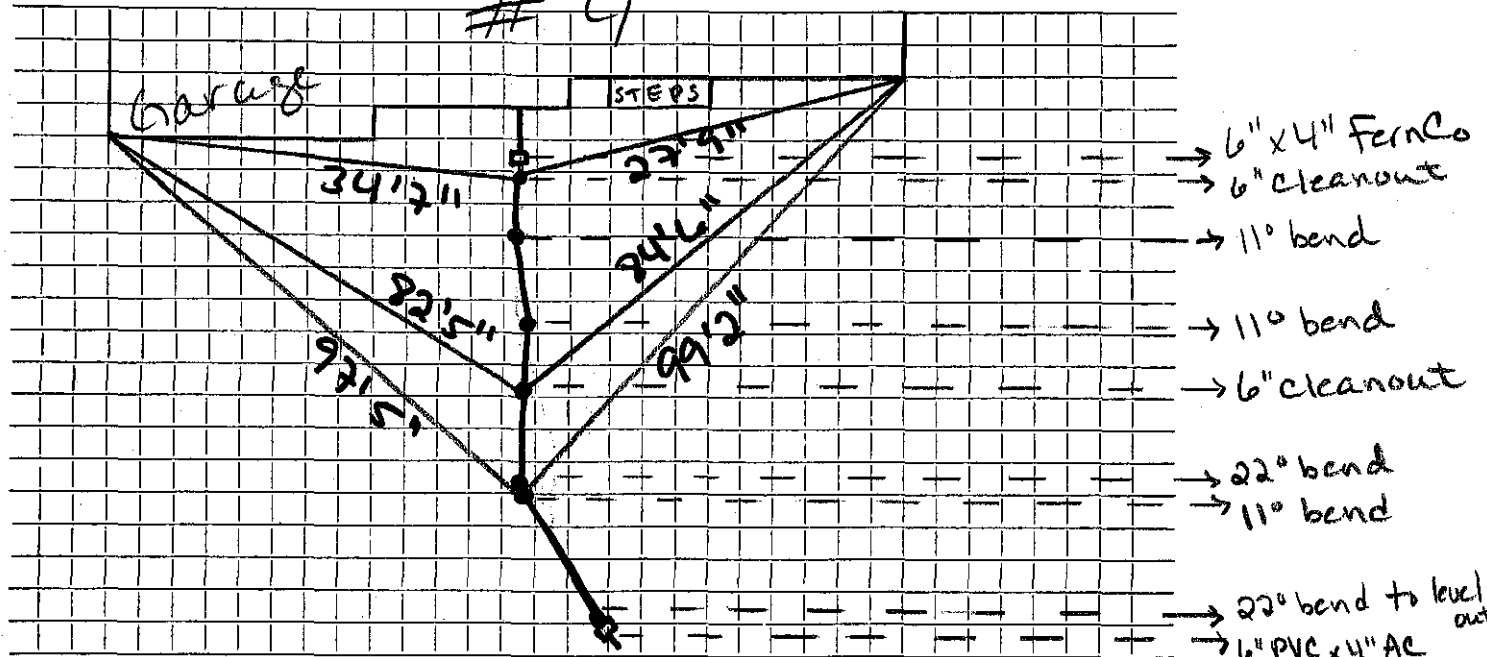

- 6" x 4" FernCo
- 6" cleanout
- 11° bend
- 11° bend
- 6" cleanout
- 22° bend
- 11° bend
- 22° bend to level out
- 6" PVC x 4" AC FernCo

Connection made in Augustus Rd Street.

Work completed .....

Remarks: 8" AC main down 5' 4"