

Name Pond Realty Trust

Service No.

Address 5 Augustus Road

Lot #1

Location

Kind of Pipe

Size

Size of Main

~~Repair~~ ~~Renewal~~ ~~New Service~~

DeFlice Bros. - Permit #117

Location

Date

Material

Amount

Total

Date

Amount

10-6-64 39' 6" Transite pipe

11/14/69

Islands

8/19/74


Plugged Sewer

DATE _____

TOWN OF LEXINGTON — BOARD OF PUBLIC WORKS
SEWER DIVISION

Sketch of Service Here

5

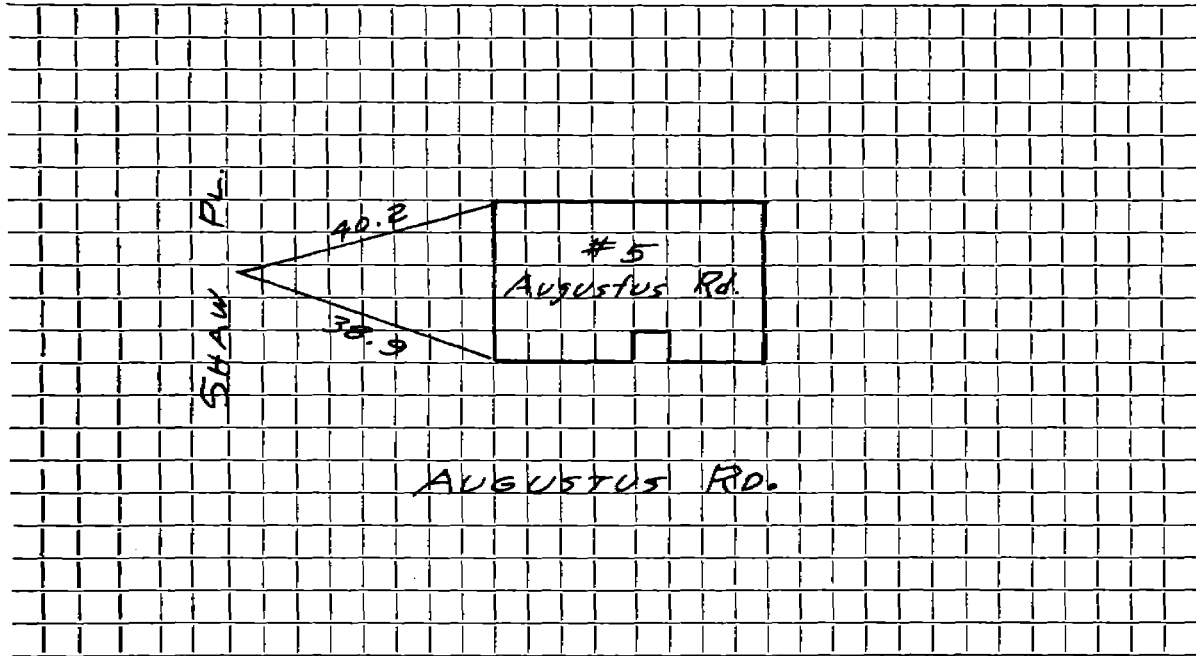

Connection made in Street. Work completed

Remarks:

.....

.....