

Name . Pond Realty

Service No.

Address 6 Augustus Road

Location

Kind of Pipe

Size

Size of Main

~~Repair - Recount~~ New Service


Location

Date		Material	Amount	Total		Date		Amount
1/4/66	50'	6" Transite Pipe						
		Repair						
10/19/66	14'	6" Trans. pipe @	88					
	3	Adapters						
		Steel Back Connect						
9-28-52	10'	6" PVC						
		2 Fittings						

DATE _____

TOWN OF LEXINGTON — BOARD OF PUBLIC WORKS
SEWER DIVISION

Sketch of Service Here **6**

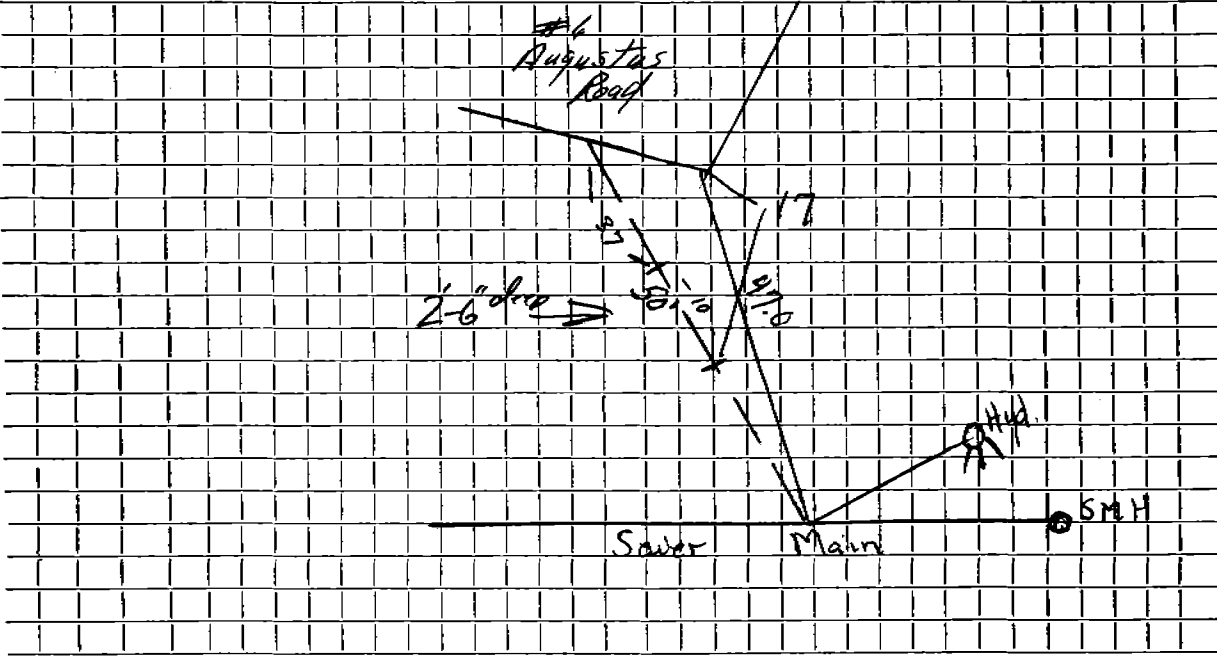

Connection made in Street. Work completed

Remarks:
.....
.....