

Name Pond Realty Trust

Service No.

Address 7 Augustus Road

Lot #10

Location

Kind of Pipe

Size

Size of Main

~~Repair - Renewal~~ - New Service

DeFlice Bros - Permit #118

Location

Date		Material	Amount		Total		Date		Amount	
10-6-64	50'	6" Transite pipe								

10-6-64



50' 6" Transite pipe

1-31-79 Ran a Snake

DATE _____

TOWN OF LEXINGTON — BOARD OF PUBLIC WORKS
SEWER DIVISION

Sketch of Service

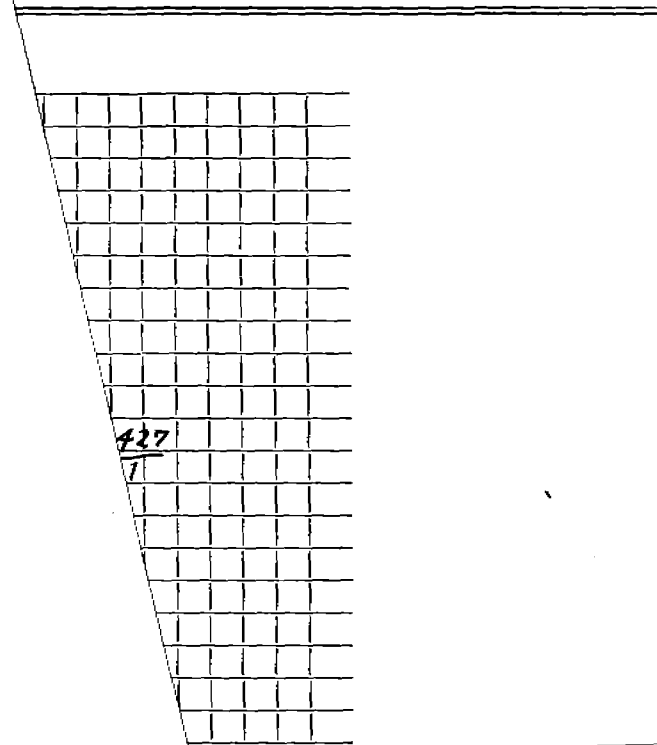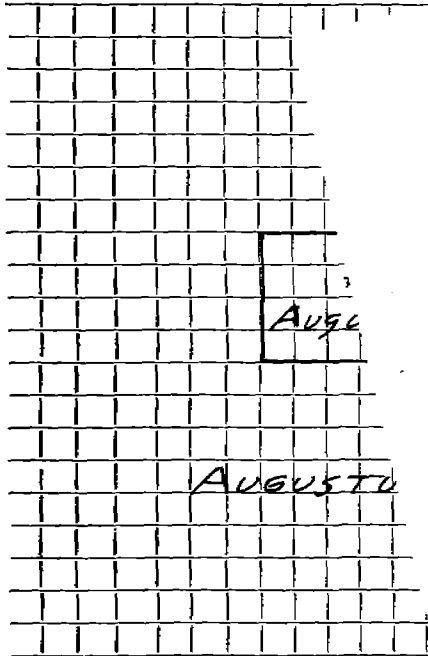

Connection made in

Remarks:

.....
.....

