

Name

Service No.

Address

8 AUGUSTUS RD (#8)

Location

Kind of Pipe

SDR 35

Size

PVC 6"

Size of Main

Repair

~~Renewal~~

New Service

Location

Date

Material

Amount

Total

Date

Amount

2017

6" SDR

CLEAN OUT

- 6" SDR DISK

- 6" TEE W/6"

- 6" PVC CAP

22" PVC DEND


6x6" FERRO

SPR & AC

DATE 2017

TOWN OF LEXINGTON — BOARD OF PUBLIC WORKS  
SEWER DIVISION

Sketch of Service Here

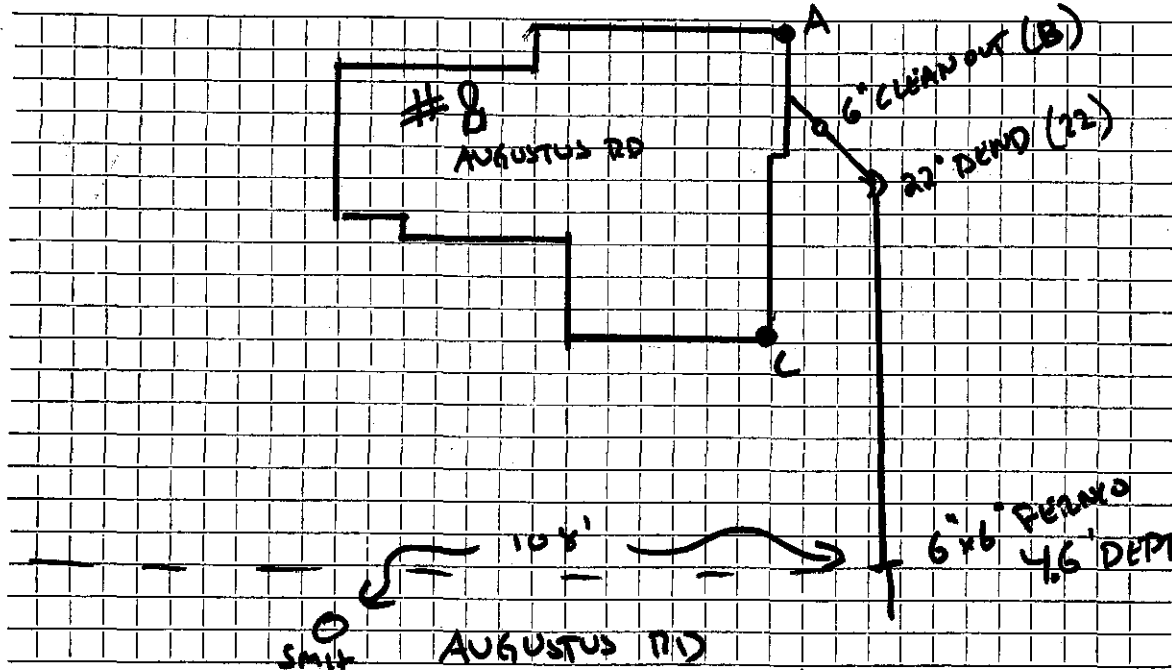

AB → 37.4'  
A22 → 57.5'  
CD → 52.0'  
C22 → 43.8'  
CD → 56.0'  
ED → 10'

Connection made in Augustus Street. Work completed .....

Remarks: #8 Augustus