

Name Myron Graffam

Service No. 105

Address 12 Avon Street

Location

Kind of Pipe

Size

Size of Main

~~Repair~~ ~~Renewal~~ New Service W.O. # 9120 John Brucchi #1756

Location DEC 31 1970

Date	Material	Amount	Total	Date	Amount
10/27/70	Labor		102 40	11-22-70	150 00
	10% O.H.		10 24	1-26-71	26 58
30'	6" Transite pipe .90		27 00		176 58
1	90o x 6" Elbow		5 65		
1-	6" Nipple		1 20		
1	6" Plug		2 11		
1/4	Bag cement 1.90		48		
1	Hr. Trucking		3 00		
1	Hr. Loader		5 00		
3	Hrs. Shovel 6.50		19 50		
			176 58		
11-19-70	14' 6" Transite pipe				
	7' 4" Cast Iron Pipe				

Deposit
Paid


11-22-70
1-26-71

DATE _____

TOWN OF LEXINGTON — BOARD OF PUBLIC WORKS

SEWER DIVISION

Sketch of Service Here **12**

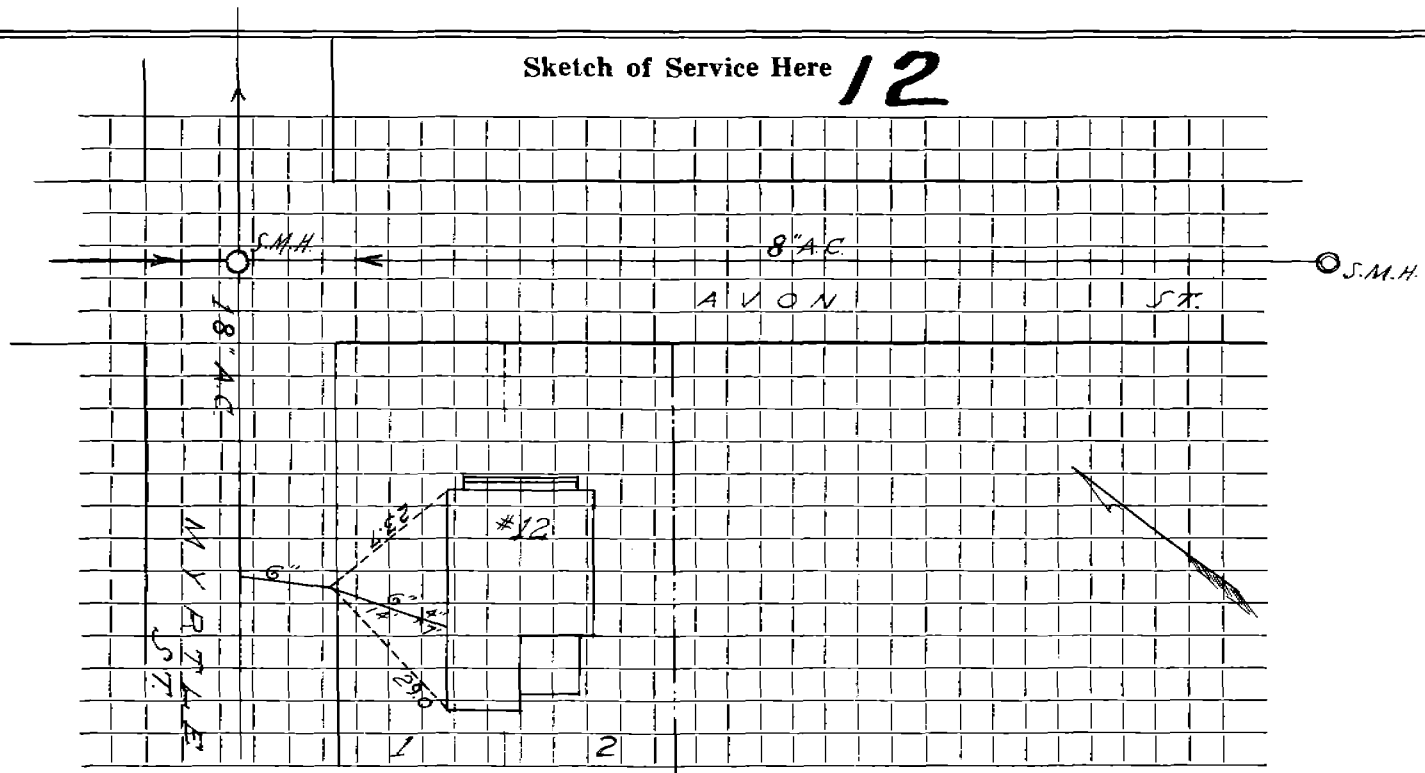

Connection made in Street. Work completed

Remarks:
.....
.....