

Name HAMILTON COMPANY

Service No.

Address #10 BAKER AVENUE

Location

Kind of Pipe

Size

Size of Main

Repair

Renewal

New Service

PERMIT NO. 0484 - McLAUGHLIN

Location

Date

Material

Amount

Total

Date

Amount


3/15/95

43' - 6"  $\phi$  P.V.C.

DATE 15 MARCH 1995

TOWN OF LEXINGTON — BOARD OF PUBLIC WORKS  
SEWER DIVISION

Sketch of Service Here **10**

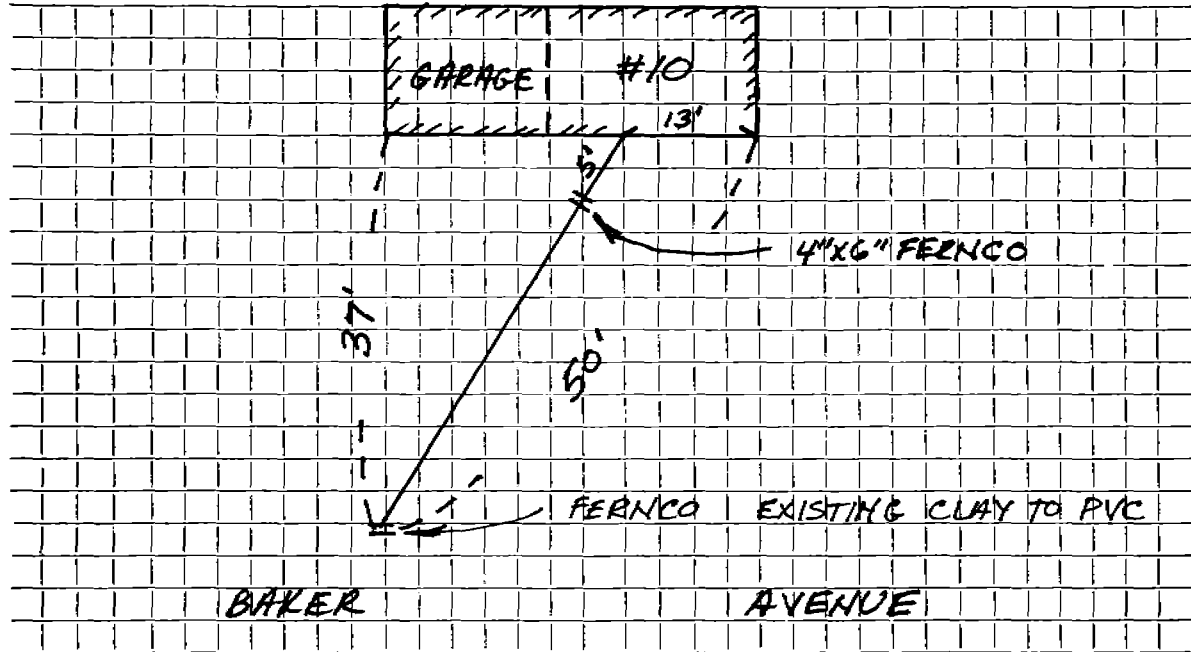

Connection made in BAKER AVENUE Street. Work completed J.M. MCLAUGHLIN

Remarks: Original Service 9-24-29

BOOK 96A

J.W.