

Name Donald Cruwys

Service No. 213

Address 18 Baker Avenue

Location

Kind of Pipe

Size

Size of Main

~~Repair~~ ~~Work~~ New Service W.O. #7755


Location Comm 3-25-63

Date	Material	Amount	Total	Date	Amount
12-12-62	Labor	67.60		12-3-63	250.00
12-14-62	"	76.33	143.93	3-25-63	21.25
	10% C.H.	14.39	158.32	3-25-63	2.53
	53' 6" Transite pipe @.82		43.46		274.28
	5 hrs. Town Shovel @6.50		32.50		
	2 hrs. Trucking @3.00		6.00		
	1 hr. Compressor @5.00		5.00		
	2 hrs. Town Shovel @6.50		13.00		
	16 x 3 Patch		16.00		
			274.28		

DATE _____

TOWN OF LEXINGTON — BOARD OF PUBLIC WORKS
SEWER DIVISION

Sketch of Service Here **18**
18 BAKER

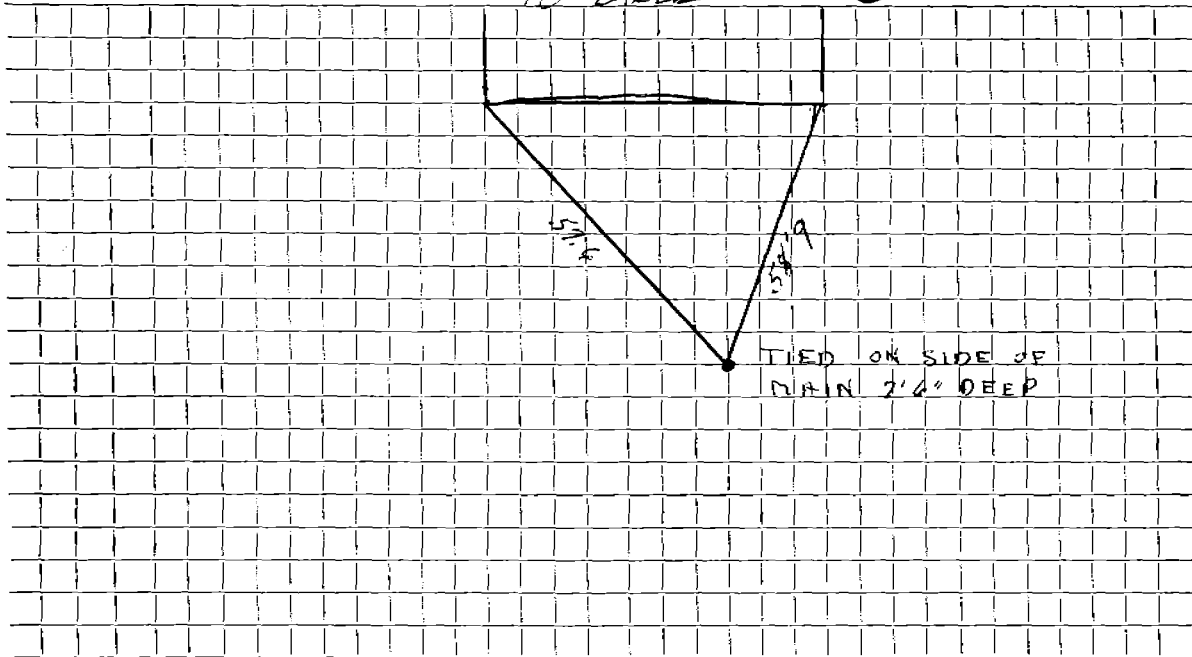

Connection made in Street. Work completed

Remarks:

.....
.....