

Name Frank E. Hudson  
 Address <sup>23</sup> 27 Baker Avenue

Service No. 45 29

Location

Kind of Pipe

Size

Size of Main

~~Repair-Renewal~~ - New Service

Location

Date	Material	Amount	Total	Date	Amount
C 9-24-29	30' 6" Sewer Pipe @.30	9 00			
for 64.83	10' 4" Iron Pipe @.50	5 00			
	Sulphur & Jute	1 20			
	Trucking	75	15 95		
9/4/29	74 Hrs. Labor @.55	40 70			
	3 " " @.60	1 80	42 50		
	15% Overhead		6 38		
			64 83		
	Labor				

Jan. 6 1930 - Cash

64 83

Hadley Press, Inc., Lexington

**TOWN OF LEXINGTON—BOARD OF PUBLIC WORKS**  
**SEWER DIVISION**

DATE \_\_\_\_\_

NO. \_\_\_\_\_


The undersigned applies for the construction of a particular sewer connecting No. \_\_\_\_\_ Street and hereby agrees to comply with the Rules and Regulations governing the construction and use of Particular Sewers, as now or at any future time established by the Board of Selectmen.

Am't. of Estimate \$ \_\_\_\_\_

Am't. Paid \$ \_\_\_\_\_

\_\_\_\_\_ Owner

**Sketch of Service Here**

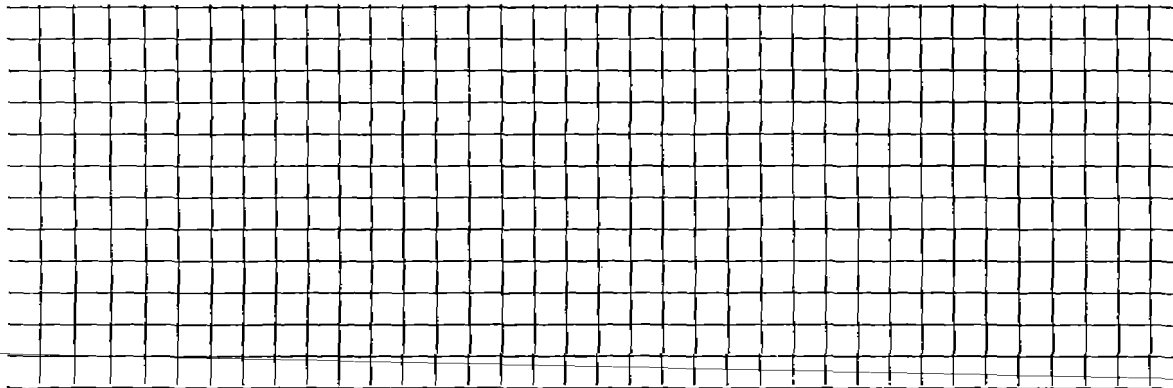

Connection made in \_\_\_\_\_ Street.

Work completed \_\_\_\_\_ 19

Remarks: