

Name Dennis C. O'Connell

Service No. 230

Address 54 Norcross Street, Arlington

Location Lots #290, 291 Baker Ave. #24

Kind of Pipe

Size

Size of Main

~~Repair - Renewal~~ - New Service

Location

Date	Material	Amount	Total	Date	Amount
P. 4-14-31	30' 6" Sewer Pipe @ .25	7 50			
	1 6"-1/8" Bend	70			
	Sulphur & Jute	1 20			
	Trucking	75			
	Comp. Breaking 3 Hrs. @.	<u>10 00</u>			
			20 15		
				Feb 28 1931 - Cash	45 -
				Jan 18 1932 - Cash	9 08
3/13/31	46 Hrs. Labor @ .55	25 30			
	7 " " @ .60	<u>4 20</u>			
			29 50		
	15% Overhead		4 43		
			<u>54 08</u>		
	Labor				

Hadley Press, Inc. Lexington

TOWN OF LEXINGTON—BOARD OF PUBLIC WORKS

SEWER DIVISION

DATE March 2, 1931

Raker Ave NO. _____


The undersigned applies for the construction of a particular sewer connecting No. 2 Chase Avenue Street and hereby agrees to comply with the Rules and Regulations governing the construction and use of Particular Sewers, as now or at any future time established by the Board of Selectmen.

Am't. of Estimate \$ _____

Am't. Paid \$ _____

E. O. ...
Matthew Hursey Owner

Sketch of Service Here

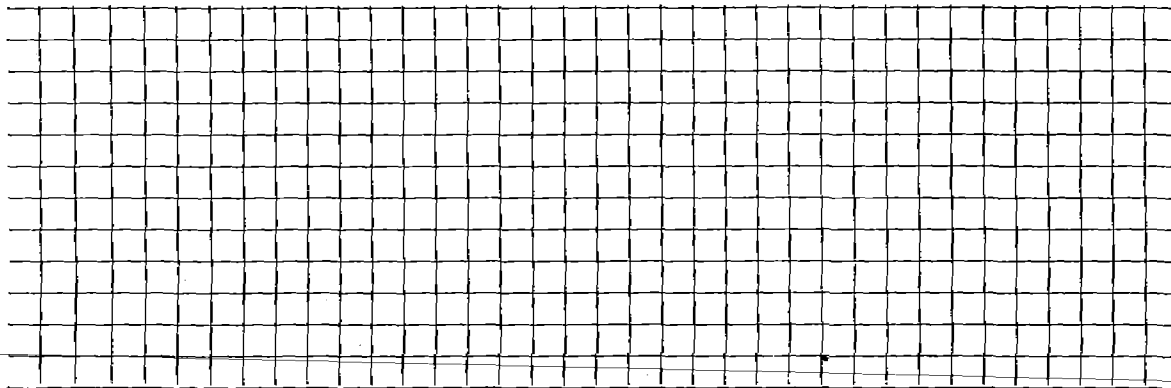

Connection made in _____ Street.

Work completed _____ 19

Remarks: