

Name Rudolph F. Carlson

Service No. 37 31

Address ~~7830~~ 34 Baker Avenue

Location

Kind of Pipe

Size

Size of Main

~~Repair-Renewal~~—New Service

Location

Date	Material	Amount	Total	Date	Location	Amount
------	----------	--------	-------	------	----------	--------

6-9-24-29	50' 6" Sewer Pipe @ .30	15 00				
for 4.25	2 1/8" Bends @ .70	1 40		Aug. 30 1929	- Cash	25
	1 6" Y	1 05		Oct. 16 1929	- Cash	16 25
	Sulphur & Jute	2 00				
	Trucking	<u>75</u>	20 20			
	30 Hrs. Labor @ .55	16 50				
9/5/29	3 " " @ .60	<u>1 80</u>	18 30			
	15% Overhead		<u>2 75</u>			
			<u>41 25</u>			

Labor

Hadley Press, Inc., Washington

*Dig own trench*

TOWN OF LEXINGTON—BOARD OF PUBLIC WORKS

SEWER DIVISION

DATE August 30, 1938

NO. \_\_\_\_\_


The undersigned applies for the construction of a particular sewer connecting No. 34 Baker Ave. Street and hereby agrees to comply with the Rules and Regulations governing the construction and use of Particular Sewers, as now or at any future time established by the Board of Selectmen.

Am't. of Estimate \$ \_\_\_\_\_

Am't. Paid \$ 25 \_\_\_\_\_

Rudolph F. Carlson. Owner

Sketch of Service Here

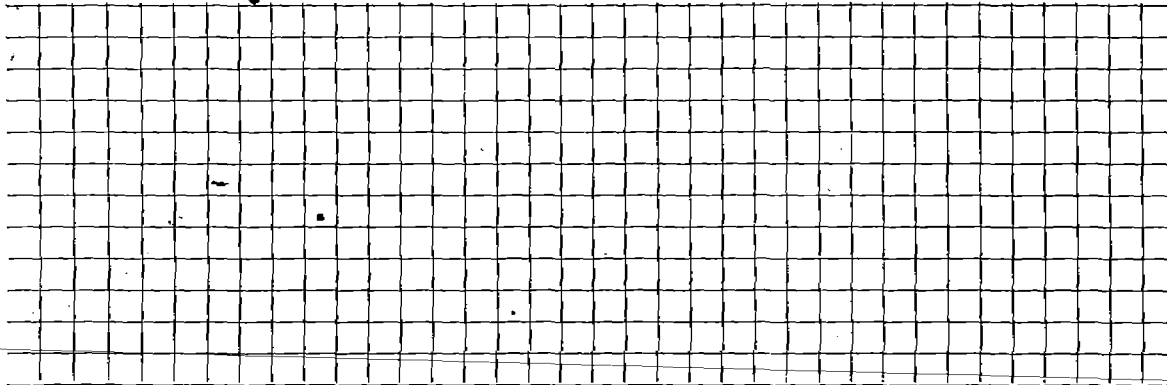

Connection made in \_\_\_\_\_ Street.

Work completed \_\_\_\_\_ 19

Remarks: