

Name Henry Olson

Service No. 96

Address 41 Baker Avenue

Lexington, Mass.

Location 41 Baker Avenue

Kind of Pipe

Size

Size of Main

Repair ~~Renewal~~ - New Service

Com. 3-6-50

Location

Date		Material	Amount		Total	Date		Amount	
Jan. 18	'50	Labor	21	70					
		"	80	30		Aug. 29 '49	Deposited	150	00
			102	00		Oct. 23 '50	Card	14	38
		10% Overhead	10	20				164	38
					112	20			
		44' - 6" Sewer Pipe @.26			11	44			
		Joint Compound			2	64			
		12 lbs. Dynamite @.22			2	64			
		8 Exploders @.12				96			
		2 hrs. Compressor			3	50			
		4 hrs. Littlefield Shovel			28	00			
		4 hrs. Trucking @.75			3	00			
		Labor			164	38			
		(LEDGE)							

TOWN OF LEXINGTON—DEPT. OF PUBLIC WORKS
SEWER DIVISION

DATE

NO.

The undersigned applies for the construction of a particular sewer connecting No.
Street and hereby agrees to comply with the Rules and Regulations governing the construction and use of Particular
Sewers, as now or at any future time established by the Board of Selectmen.


Am't of estimate \$.

Am't Paid \$.

..... Owner

Sketch of Service Here

.....

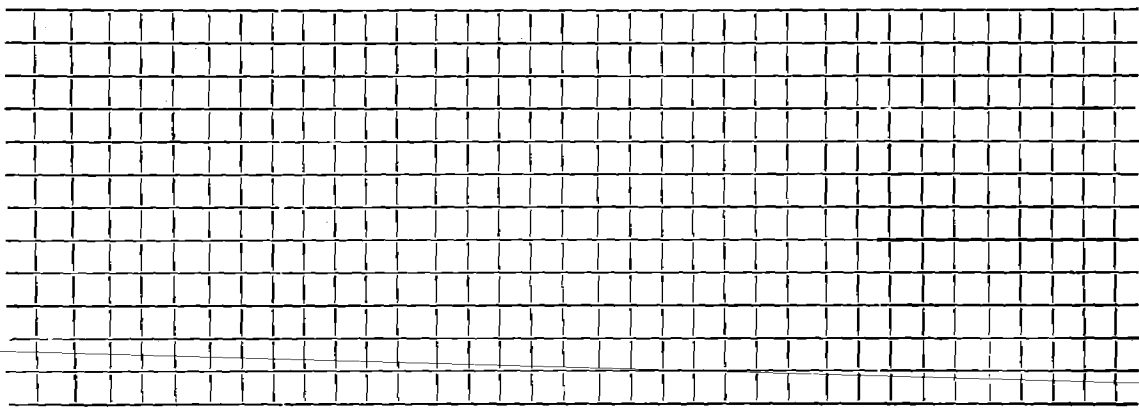

A large rectangular grid with approximately 20 columns and 15 rows, intended for drawing or sketching details of a sewer service.

Connection made in Street. Work completed 19..

Remarks: