

Name Eluhu Schumann

Service No. 19

Address 51 Baker Avenue

Lexington, Mass.

Location 51 Baker Avenue

Kind of Pipe

Size

Size of Main

~~Repair or Renewal~~ - New Service

Com. 8-6-51

Location

Date	Material	Amount	Total	Date	Amount
5-2-51	Labor	44 29	44 29	April 3 '51	Reported 90 00
	10% Overhead		4 43	8-17-51	Paid 3 65
	1/4" - 6" Sewer Pipe @.34/l		15 14	7-22-54	Paid (9 23
	1 - 6" Elbow		1 88	8-6-51	10 2 88
	Joint Compound		2 64	" "	3-24-52
	Littlefield Shovel 3 hrs. @7.00		21 00		
	Trucking 2 hrs. @.75		1 50		
	Patching 12 x 3		12 00		
			102 88		
	Labor				

**TOWN OF LEXINGTON—DEPT. OF PUBLIC WORKS  
SEWER DIVISION**

DATE .....

NO. ....

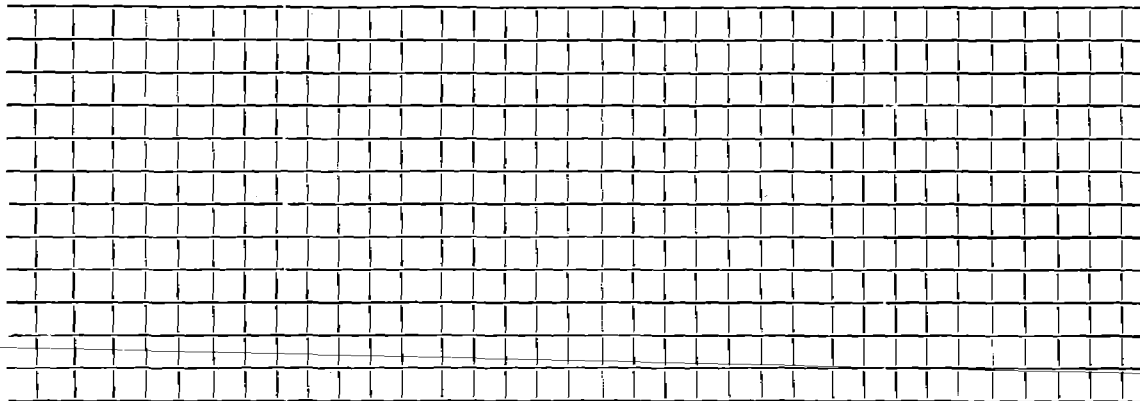
The undersigned applies for the construction of a particular sewer connecting No. ....  
Street and hereby agrees to comply with the Rules and Regulations governing the construction and use of Particular  
Sewers, as now or at any future time established by the Board of Selectmen.

Am't of estimate \$. ....

Am't Paid \$. ....

..... Owner

**Sketch of Service Here**

A large rectangular area filled with a grid of small squares, intended for a hand-drawn sketch of the sewer service details.

Connection made in ..... Street.                  Work completed ..... 19..

Remarks: