

Name James Carlan

Service No. 63

Address 63 Baker Avenue

Sta. 5+67 right

Location

Kind of Pipe

Size

Size of Main

~~REPAIR OR RENEWAL~~ New Service Valeri Const. Permit #A296

Location JUN 23 1966

Date	Material	Amount	Total	Date	Amount
9-16-63	Labor	85.68		5-16-66	137.78
	10% O.H.	8.57	94.25	<i>Deposit</i>	
	17' 6" Transite pipe @.82		13.94		
	1 90° Transite Elbow		4.09		
	3 hrs. Town Shovel @6.50		19.50		
	2 hrs. Trucking @3.00		6.00		
	BILL WHEN CONNECTED		137.78		
5-18-66	12' 6" Transite pipe				
	10' Cast iron pipe				


DATE _____

TOWN OF LEXINGTON — BOARD OF PUBLIC WORKS
SEWER DIVISION

Sketch of Service Here

63 BAKER

63

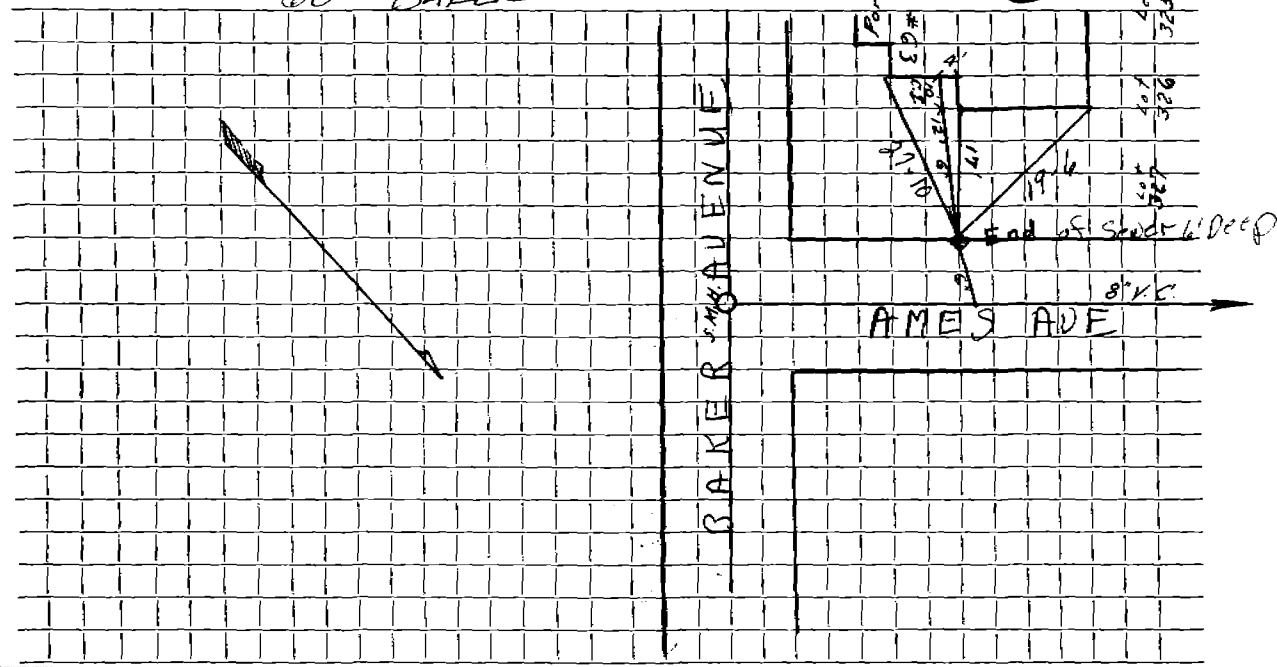

Connection made in Street. Work completed

Remarks:
.....
.....