

Name Mr. Herbert McDonshie

Service No. 72 26

Address 13 Sylvia St.

Location 7 Ker Ave.

Kind of Pipe Size Size of Main

Repair—Renewal—New Service Location

Date	Material	Amount	Total	Date	Amount
<i>in for 61.64</i>	43' 3" Sewer Pipe @ .25	10 75			
<i>8-4-31</i>	Sulphur & Jute	1 72			
	Emmeking	<u>75</u>	13 22	<i>July 6 1931 - Cash</i>	<i>61 64</i>
<i>10/31</i>	70 Hrs. Labor @ .55	38 50			
	8 " " @ .60	<u>3 60</u>	42 10		
	15' Overhead		<u>6 32</u>		
			61 64		
	Labor				

Hadley Press, Inc., Lexington

TOWN OF LEXINGTON—BOARD OF PUBLIC WORKS

SEWER DIVISION

DATE May 22, 1931

NO. _____


The undersigned applies for the construction of a particular sewer connecting No. 7 Baker Ave. Street and hereby agrees to comply with the Rules and Regulations governing the construction and use of Particular Sewers, as now or at any future time established by the Board of Selectmen.

Am't. of Estimate \$ _____

Am't. Paid \$ _____

Herbert Melonchi Owner

Sketch of Service Here

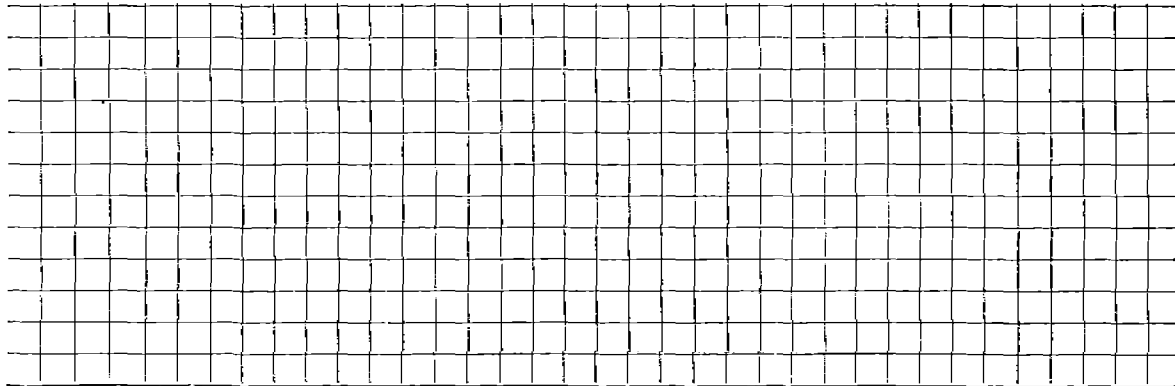

Connection made in _____ Street.

Work completed _____ 19

Remarks: