

Name Arthur G. Damery

Service No. 11 83

Address 76 Baker Avenue, Lexington

Location

Kind of Pipe

Size

Size of Main

~~Repair~~ - Renewal - ~~New Service~~

Location

Date 1943	Material	Amount	Total	Date	Amount
July 12, <i>Com</i> 9/13/43	24 hrs. @ 65¢	15 60		Jan 1943 Deposited	70 00
	4 " @ 70¢	2 80		Sept 15, 1943 Refund	14 15
	16 " @ 80¢	12 80	31 20		<u>55 85</u>
	10% Overhead		3 12		
	42' 6" Sewer Pipe @ 16¢		6 72		
	10' 4" Iron Pipe @ 50¢		5 00		
	Joint compound		2 52		
	1 hr. compressor @ 2.25		2 25		
	2 hrs. trucking @ 75¢		1 50		
	Trench repairs		3 54		
			55 85		
	Labor			12/27/67 papers	
				8/13/69	
				5'21.02	
				Hit roots 8'	Homeowner's problem

Hadley Press, Inc., Lexington

TOWN OF LEXINGTON - BOARD OF PUBLIC WORKS

SEWER DIVISION

DATE May 1, 1943


NO. _____

The undersigned applies for the construction of a particular sewer connecting No. 76 Baker Ave. Street and hereby agrees to comply with the Rules and Regulations governing the construction and use of Particular Sewers, as now or at any future time established by the Board of Selectmen.

Am't. of Estimate \$ 70⁰⁰ owner pays

Am't. Paid \$ _____

Arthur S. Damery, Owner

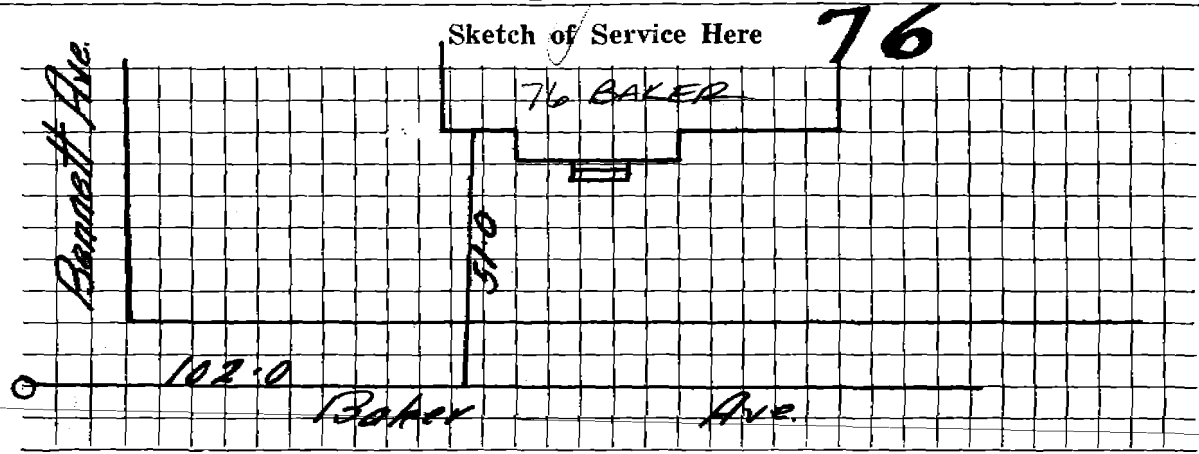

Connection made in _____ Street.

Work completed _____ 19

Remarks: